


CONTRACT DRAWINGS - FOR - Pawtucket Regional Water Treatment Facility Pkg 9 - Upper Concrete

Pawtucket, Rhode Island

INDEX

OCTOBER 31, 2006

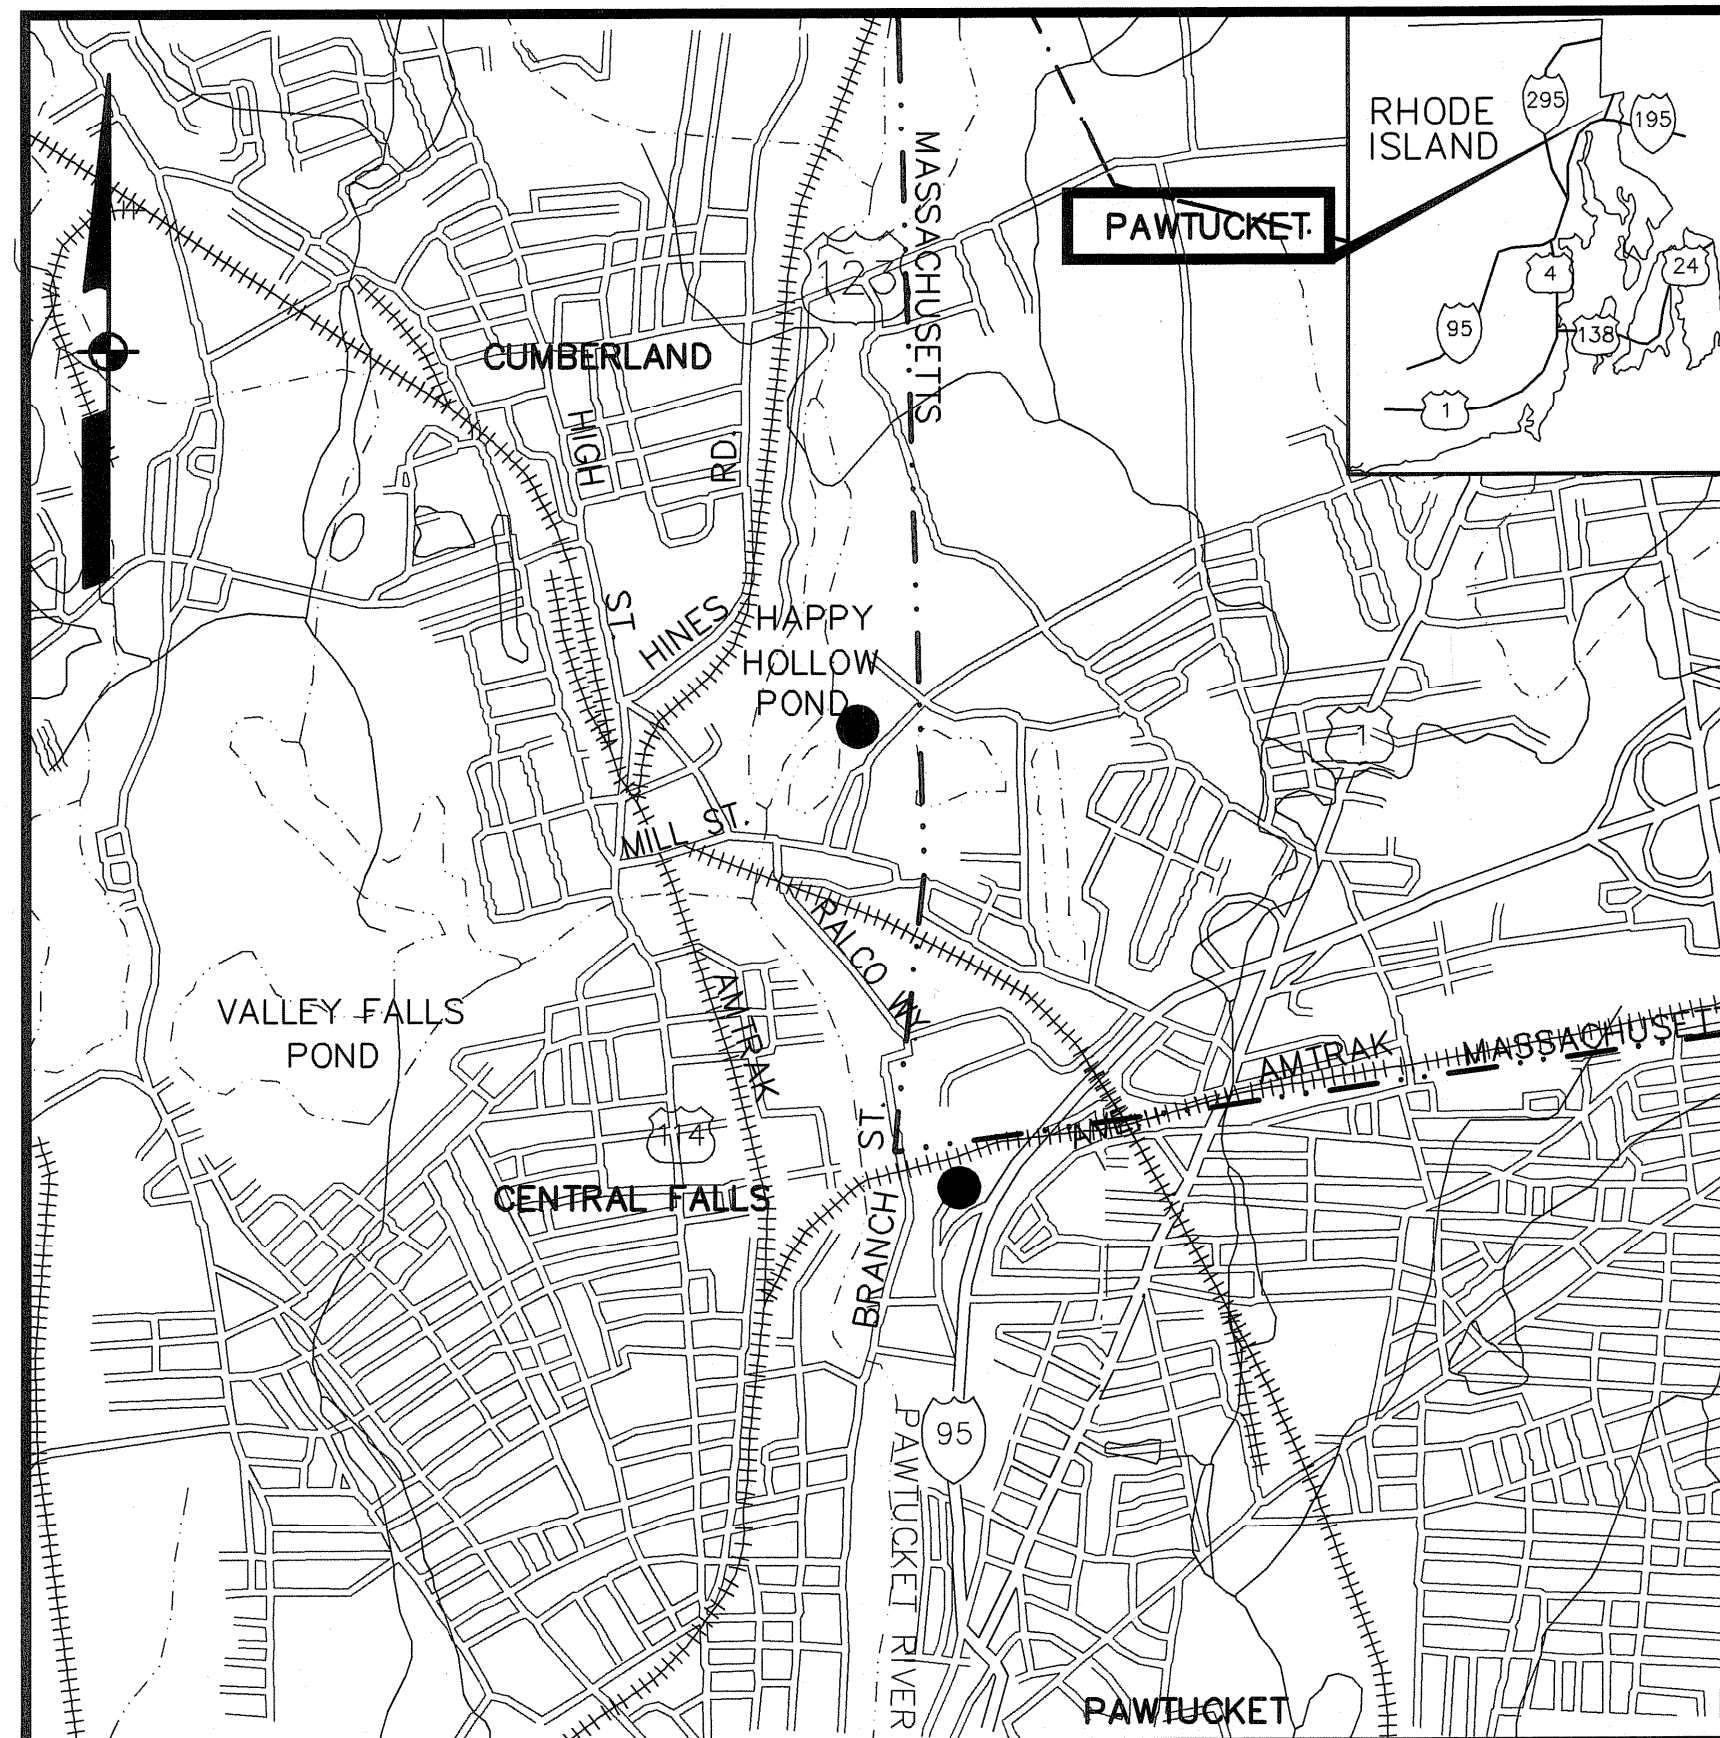


DWG.

TITLE

	COVER
	STRUCTURAL
S-2	LOWER LEVEL PLAN - EL. 57.50
S-3	UPPER LEVEL FLOOR AND LOWER ROOF PLAN - EL. 74.83
S-4	ROOF PLAN
S-4	PIPE GALLERY COVER PLAN - EL. 57.50 AND UPPER ROOF PLAN - EL. 88.17
S-5	SECTIONS AND DETAILS
S-6	SECTIONS AND DETAILS
S-7	SECTIONS AND DETAILS
S-8	SECTIONS AND DETAILS
S-9	STRUCTURAL DETAILS AND NOTES
S-10	SECTIONS AND DETAILS
S-11	PIPE GALLERY-PIPE SUPPORT FRAMING PLAN, AND SECTIONS AND DETAILS
S-12	ROOF FASCIA FRAMING PLAN AND SECTIONS AND DETAILS
S-13	PUMP BASE DETAILS
	MECHANICAL
M-2	PLAN AT ELEVATION 57.50 (LOWER LEVEL)
M-4	PIPE GALLERY - PLANS AT ELEV. 52.00 AND 57.00
M-5	PIPE GALLERY - PLANS AT ELEV. 52.00 AND 57.00
M-6	SECTIONS AND DETAILS
M-7	SECTIONS - PIPE GALLERY
M-8	SECTIONS - PIPE GALLERY
	FOR REFERENCE ONLY SEE PACKAGE 6
	HVAC
H-3	HVAC PLANS AND DETAILS
H-4	HVAC UPPER FLOOR PLAN, SECTIONS AND DETAILS
	FOR REFERENCE ONLY SEE PACKAGE 5
	PLUMBING
P-3	FLOOR PLAN - PLUMBING SANITARY DRAINS AND VENTS
P-4	FLOOR PLAN - PLUMBING SERVICE WATER
	FOR REFERENCE ONLY SEE PACKAGE 5
	ELECTRICAL
E-28	BUILDING GROUNDING AND LIGHTNING PROTECTION PLAN
	FOR REFERENCE ONLY SEE PACKAGE 8

LOCUS
NOT TO SCALE

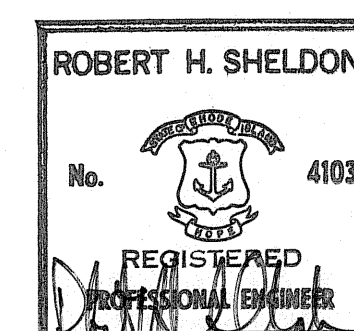

A Tyco International Ltd. Company

300 Baker Avenue Suite 290 Concord, Mass.

GENERAL NOTES

LOCATIONS OF ALL UTILITIES AND SUB-SURFACE STRUCTURES ARE FROM SURVEY AND RECORDS OF TOWN, CORPORATIONS, ETC., AND ARE CONSIDERED APPROXIMATE BOTH AS TO SIZE AND LOCATION AND ARE INDICATED ON THESE DRAWINGS TO GIVE BIDDERS A GENERAL IDEA OF EXISTING CONDITIONS TO BE INVESTIGATED BY THE BIDDER. IT IS UNDERSTOOD AND AGREED THAT EACH BIDDER WILL NOT RELY UPON THESE DRAWINGS FOR SUCH INFORMATION, BUT THAT EACH BIDDER SHALL MAKE EXAMINATIONS IN THE FIELD BY VARIOUS AVAILABLE METHODS AND SHALL OBTAIN INFORMATION FROM UTILITY CORPORATIONS AND INDIVIDUALS AS TO THE LOCATION OF ALL SUB-SURFACE STRUCTURES.

ALL ELEVATIONS REFER TO NATIONAL GEODETIC VERTICAL DATUM OF 1929.

UPPER LEVEL FLOOR AND LOWER ROOF PLAN NOTES:

- ALL INTERIOR CMU NON-LOAD-BEARING SHEAR WALLS ARE SHOWN. NOT ALL OTHER INTERIOR CMU NON-LOAD-BEARING WALLS ARE SHOWN. SEE ARCHITECTURAL DRAWINGS.
- SEE MECHANICAL, HVAC, AND PLUMBING DRAWINGS FOR ALL PRECAST PLANK PENETRATIONS REQUIRED FOR EQUIPMENT, VENTS AND ROOF DRAINS. SEE ARCHITECTURAL DRAWINGS FOR PENETRATIONS AT ANY AND ALL ROOF SCUTTLES. DESIGN PRECAST MEMBERS TO ACCOUNT FOR ALL REQUIRED PENETRATIONS.
- COORDINATE ALL OPENINGS IN CAST-IN-PLACE CONCRETE FLOOR AND ROOF SLABS WITH MECHANICAL, HVAC, PLUMBING, AND ARCHITECTURAL DRAWINGS.
- STEEL MEMBERS SHALL BE AS FOLLOWS: W-SHAPES, ASTM A992 (50 KSI); TS COLUMNS, ASTM A500 GRADE B; ANGLES, ASTM A36.


- SET BEARING PLATES ON $\frac{3}{4}$ " N.S. GROUT, TYP.
- CMU CONTROL JOINTS REQUIRED MAX 36'-0" O.C. AND W/ PROPER CONSIDERATION TO LOC'S OF WALL OP'NGS. BOND BEAM REINF. IS CONTINUOUS AT CONTROL JOINTS (SEE ARCH. DWG'S). ABOVE OP'NGS: LOCATE JOINT 8" FROM VERT. FACE OF OP'NG AT TOP OF OP'NG; JOG JOINT 8" INTO FACE OF OP'NG.
- CMU CONTROL JOINTS NEED NOT BE LOCATED AT BRICK VENEER CONTROL JOINT LOCATIONS. DO NOT LOCATE CMU CONTROL JOINTS AT THE FOLLOWING OP'NGS: DOORS 104, 107 THROUGH 109, 114 THROUGH 121, 206 THROUGH 209, 211 THROUGH 215, 218, 219, AND 223 THROUGH 226.

DESIGN LOADS (PSF=PER SQ. FT. OF FLOOR AREA):

- 250 PSF = LIVE FLOOR LOAD
- 100 PSF = LIVE CORRIDOR LOAD
- 100 PSF = LIVE FILTER PLATFORM LOAD
- 50 PSF = DEAD LOAD (CMU WALL ALLOWANCE)
- 71 PSF = 8" THICK PRECAST PLANK ALLOWANCE
- 25 PSF = 2" CONCRETE (COMPOSITE) PLANK TOPPING

ROOF LIVE LOADS: SEE LOAD DIAGRAMS, THIS SHEET
100 PSF = ROOF LIVE LOAD AT LOW ROOF OVER PUMP ROOM (SOUTH WEST LOW ROOF).

CONCENTRATED EQUIPMENT LOAD: 7,000 LB. ON 5'-6" x 7'-6" FOOTPRINT LOCATED ANYWHERE WITHIN AREA DELINEATED ON PLAN (NOT TO BE APPLIED SIMULTANEOUSLY WITH SNOW LOAD).

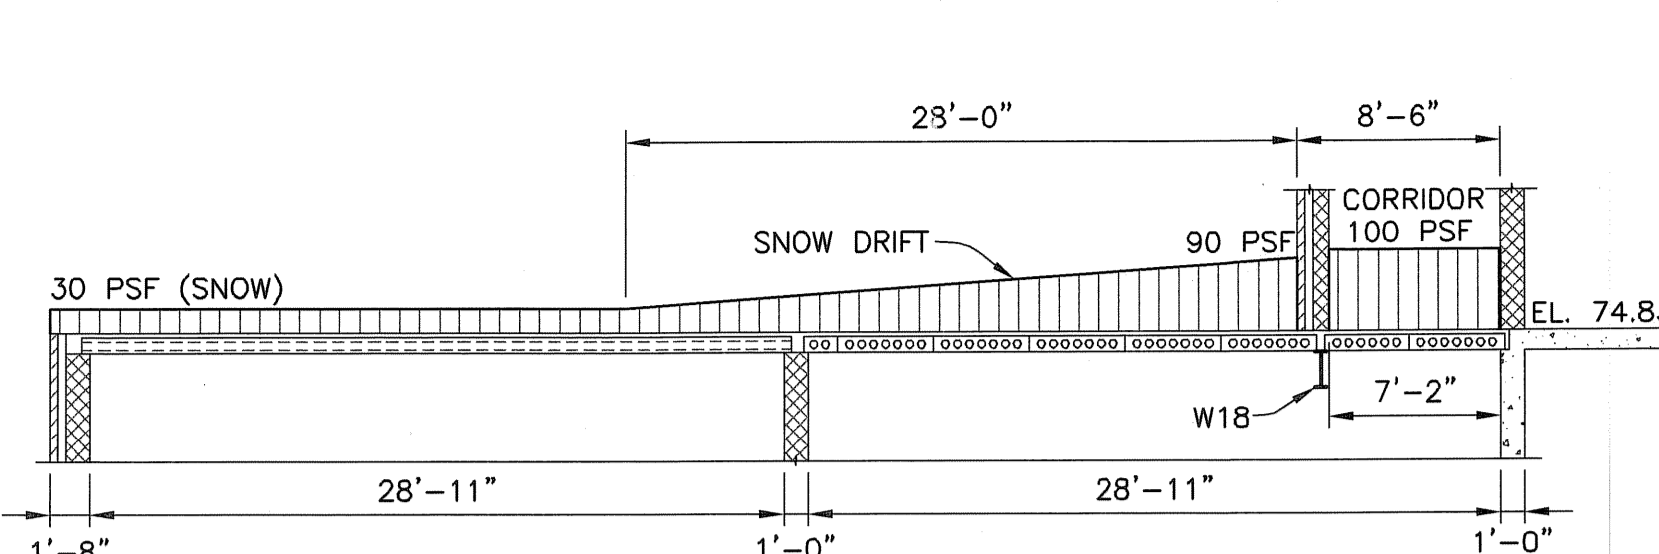

NOTES:


- ADDITIONAL MECHANICAL LOAD = 10 PSF (EXCEPT AS NOTED OTHERWISE)
- SEE DIAGRAM THIS SHEET FOR SNOW LOADING AT NORTHEAST CORNER OF BUILDING.

PRECAST PLANK LOADS

SCALE: 1/8" = 1'-0"

SNOW LOAD - NORTHEAST CORNER

SCALE: 1/16" = 1'-0"

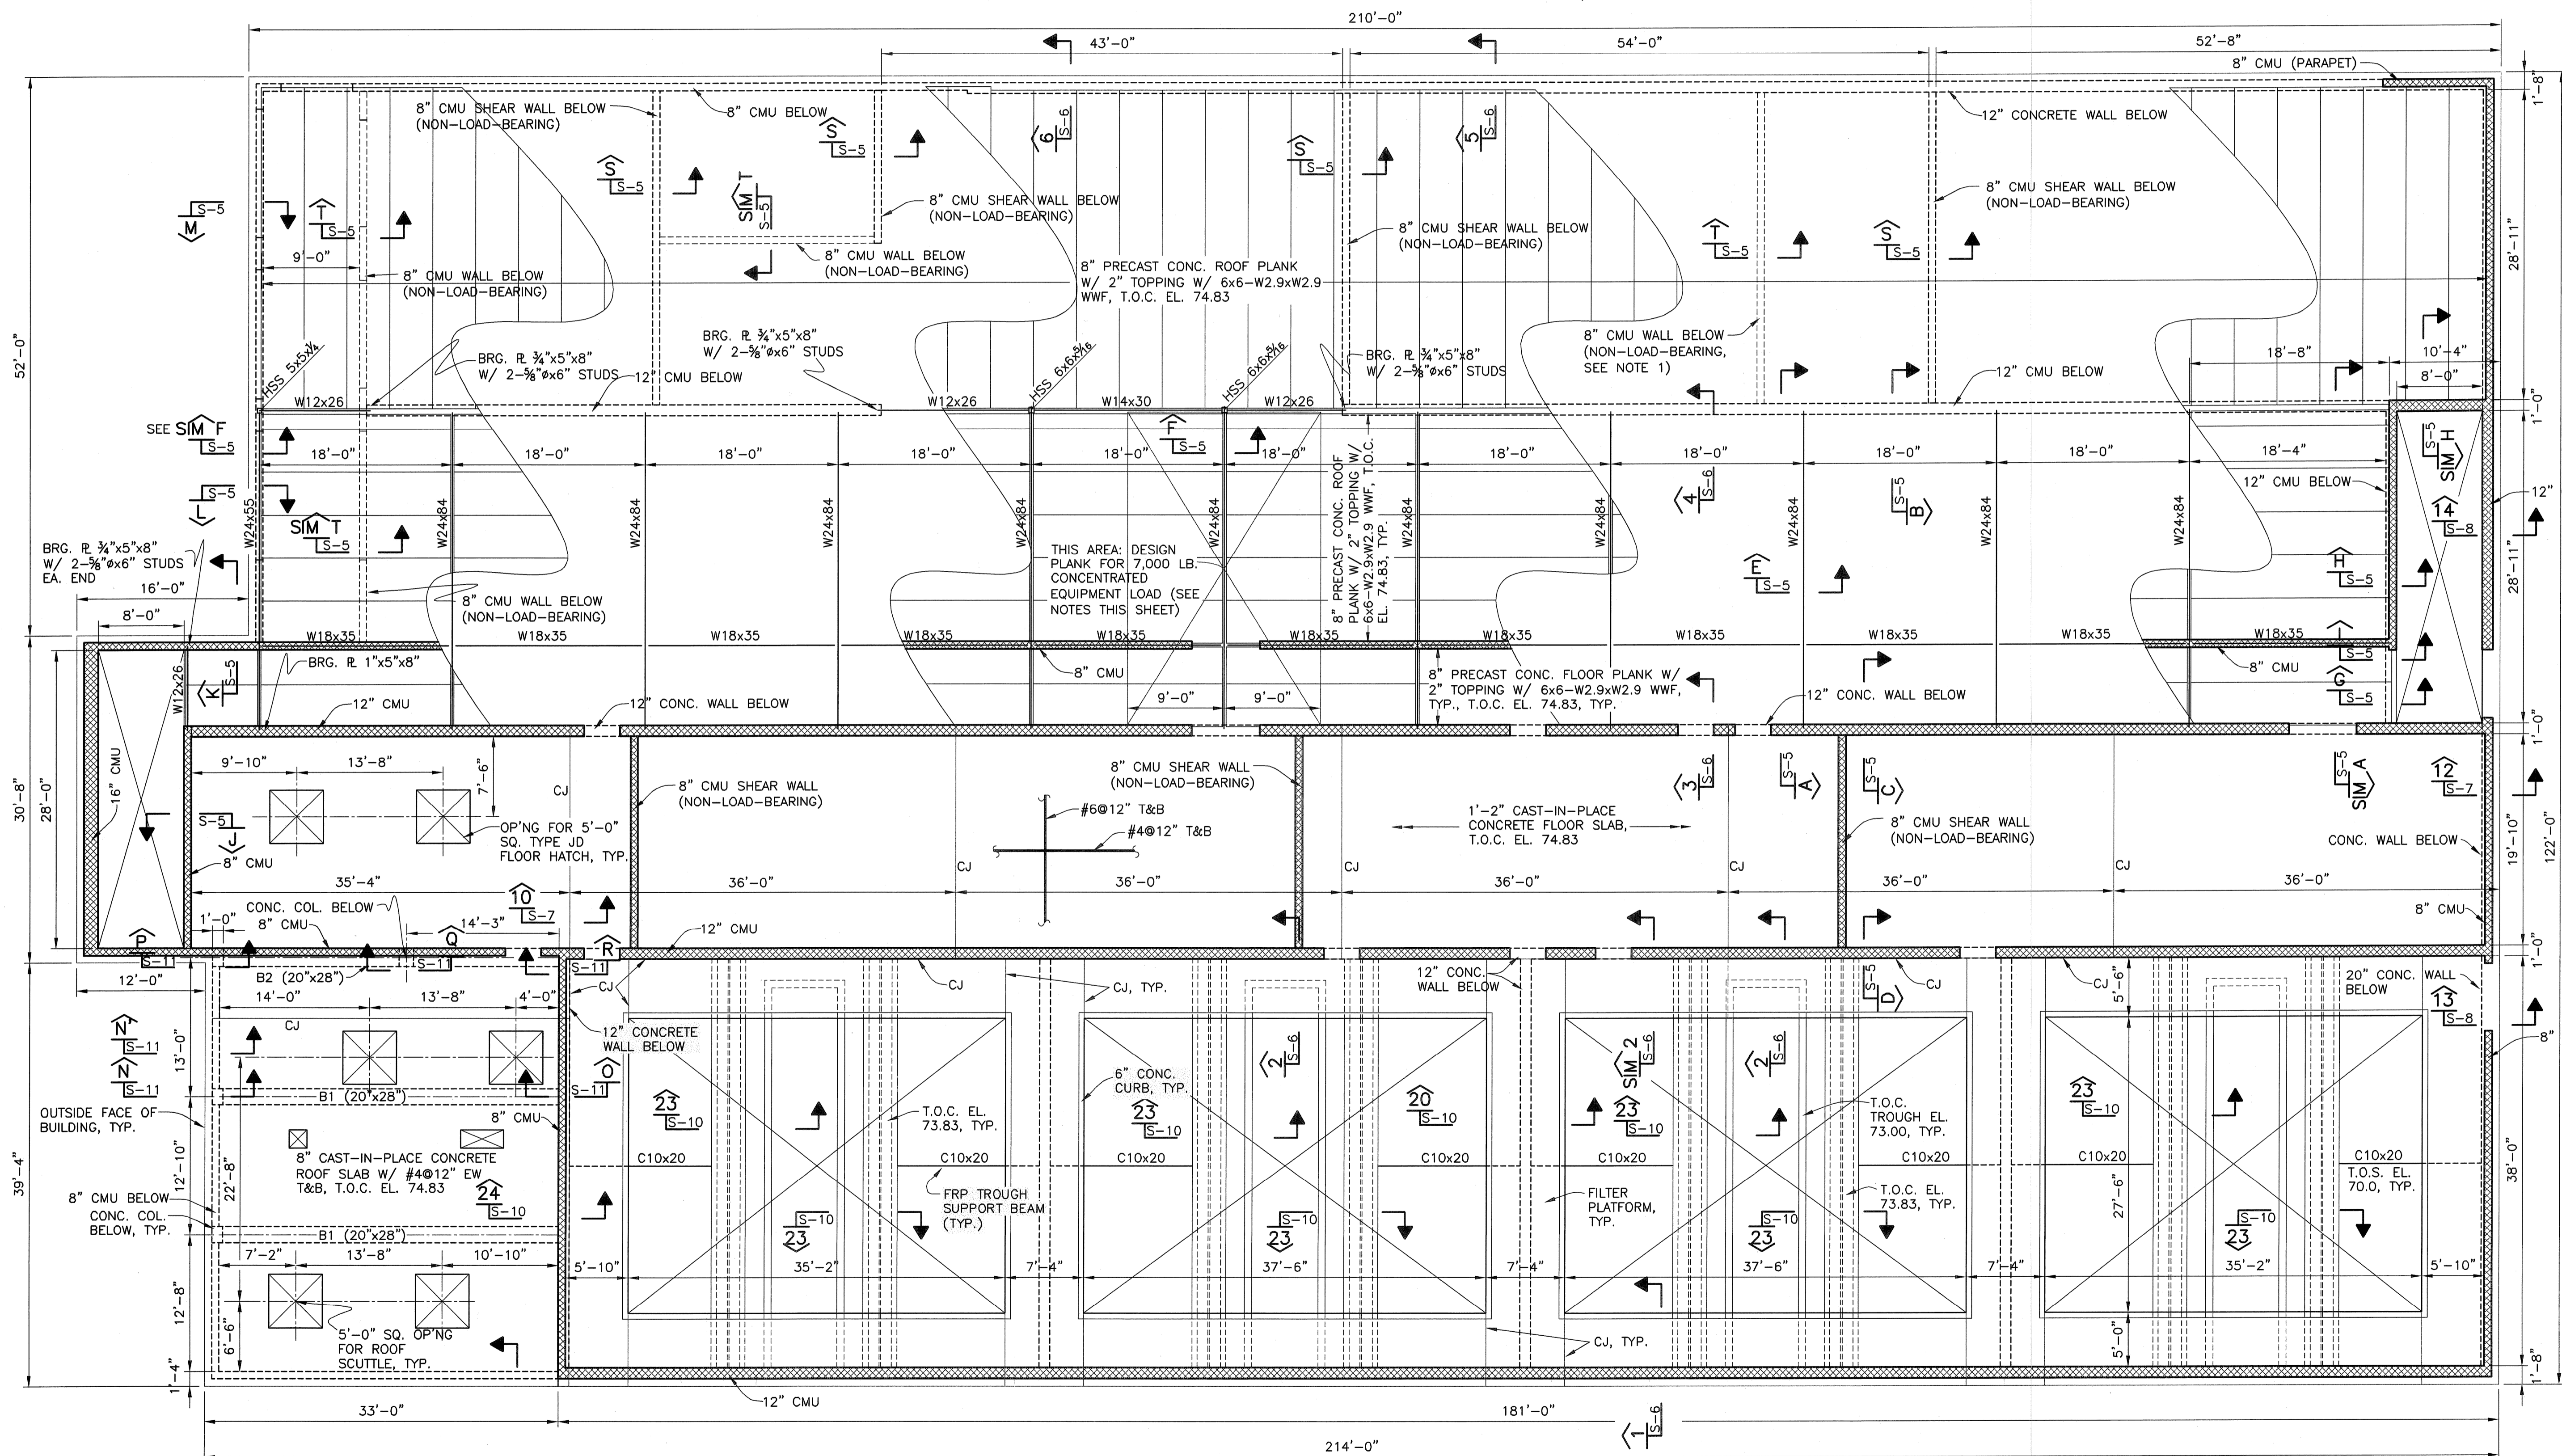

UPPER LEVEL FLOOR AND LOWER ROOF PLAN

SCALE: 1/8" = 1'-0"

EARTH TECH
AS-BUILT FILE
JULY 2008

Filename: L:\WORK\69993\CAD\AS-BUILT\9) WTP\STRUC\6999353-5-11-12.DWG
Plot File Date Created: Aug/11/2008 4:30 PM

EarthTech
A Tyco International Ltd. Company
300 BAKER AVENUE SUITE 250 CONCORD MA 01742 (978) 371-4000

NO.	DATE	BY	REVISION
2	JULY 2008	DPB	AS-BUILT DRAWING FILE
1	10/21/06	R.D.	ISSUED FOR RFI POSTED SET
0	4/05	R.D.	ISSUED FOR CONSTRUCTION

ROBERT H. SHELDON
No. 4103
Professional Engineer
3/1/08

PAWTUCKET, RHODE ISLAND
**PAWTUCKET REGIONAL
WATER TREATMENT FACILITY**
PKG 9 - UPPER CONCRETE
UPPER LEVEL FLOOR AND
LOWER ROOF PLAN - EL. 74.83

DESIGNED BY MVC	DWG SCALE 1/8" = 1'-0"
DRAWN BY MVC	CONTRACT NO.
CHECKED BY R.D.	DATE OCTOBER 31, 2008






S-3
SHEET OF

PIPE GALLERY COVER PLAN NOTES:

- ALL SUPPORT FRAMING IS ALUMINUM.
- 3/8" ALUM. TREAD PLATE PANELS SHALL NOT EXCEED 10 SQUARE FEET IN AREA.
- REINFORCE PANELS WITH STIFFENERS TO SUPPORT 100 PSF LIVE LOAD WITH A MAXIMUM DEFLECTION OF 1/360 TIMES THE SPAN OF THE PLATE.
- PROVIDE TWO RECESSED LIFT HANDLES PER PLATE.
- PRE-DRILL HOLES IN PLATES AND FASTEN TO SUPPORT FRAMING WITH 1/4" S.S. FLAT HEAD SCREWS 1'-0" O.C.. FIELD TAP HOLES IN SUPPORTS TO MATCH PLATE HOLE LOCATIONS.
- SUPPORT L'S AT WALLS NOT SHOWN. SEE DRAWING S-10 FOR TYPICAL DETAILS.
- COORD. OP'NGS REQUIRED FOR PIPING AND OTHER PENETRATIONS W/ MECHANICAL DRAWINGS AND FIELD-MEASURED LOCATIONS.
- DESIGN LOADS:
 - 200 PSF = MAXIMUM LIVE LOAD
 - 100 PSF = LIVE LOAD WITH DEFL. LESS THAN SPAN/360
- U.N.O. = UNLESS NOTED OTHERWISE

UPPER ROOF PLAN NOTES:

- ALL INTERIOR CMU NON-LOAD-BEARING SHEAR WALLS ARE SHOWN. NOT ALL OTHER INTERIOR CMU NON-LOAD-BEARING WALLS ARE SHOWN. SEE ARCHITECTURAL DRAWINGS.
- SEE MECHANICAL AND PLUMBING DRAWINGS FOR ALL PRECAST PLANK AND DOUBLE-TEE BEAM PENETRATIONS REQUIRED FOR MECHANICAL EQUIPMENT AND ROOF DRAINS. SEE ARCHITECTURAL DRAWINGS FOR PENETRATIONS AT ANY AND ALL ROOF SCUTTLES. DESIGN PRECAST MEMBERS TO ACCOUNT FOR ALL REQUIRED PENETRATIONS. (PENETRATIONS THROUGH DOUBLE-TEE BEAMS SHALL BE THROUGH FLANGES ONLY.)
- STEEL MEMBERS SHALL BE AS FOLLOWS: W-SHAPES, ASTM A992 (50 KSI); HSS COLUMNS, ASTM A500 GRADE B; ANGLES, ASTM A36.
- SET BEARING PLATES ON 3/4" N.S. GROUT, TYP.
- DESIGN LOADS:
 - 30 PSF = SNOW LOAD (PLUS DRIFT, SEE SHEET S-12)
 - 8 PSF = MECHANICAL LOAD
 - 2 PSF = ROOFING (MEMBRANE/INSULATION) ALLOWANCE
 - 25 PSF = 2" CONCRETE (COMPOSITE) PLANK AND DOUBLE-TEE BEAM TOPPING

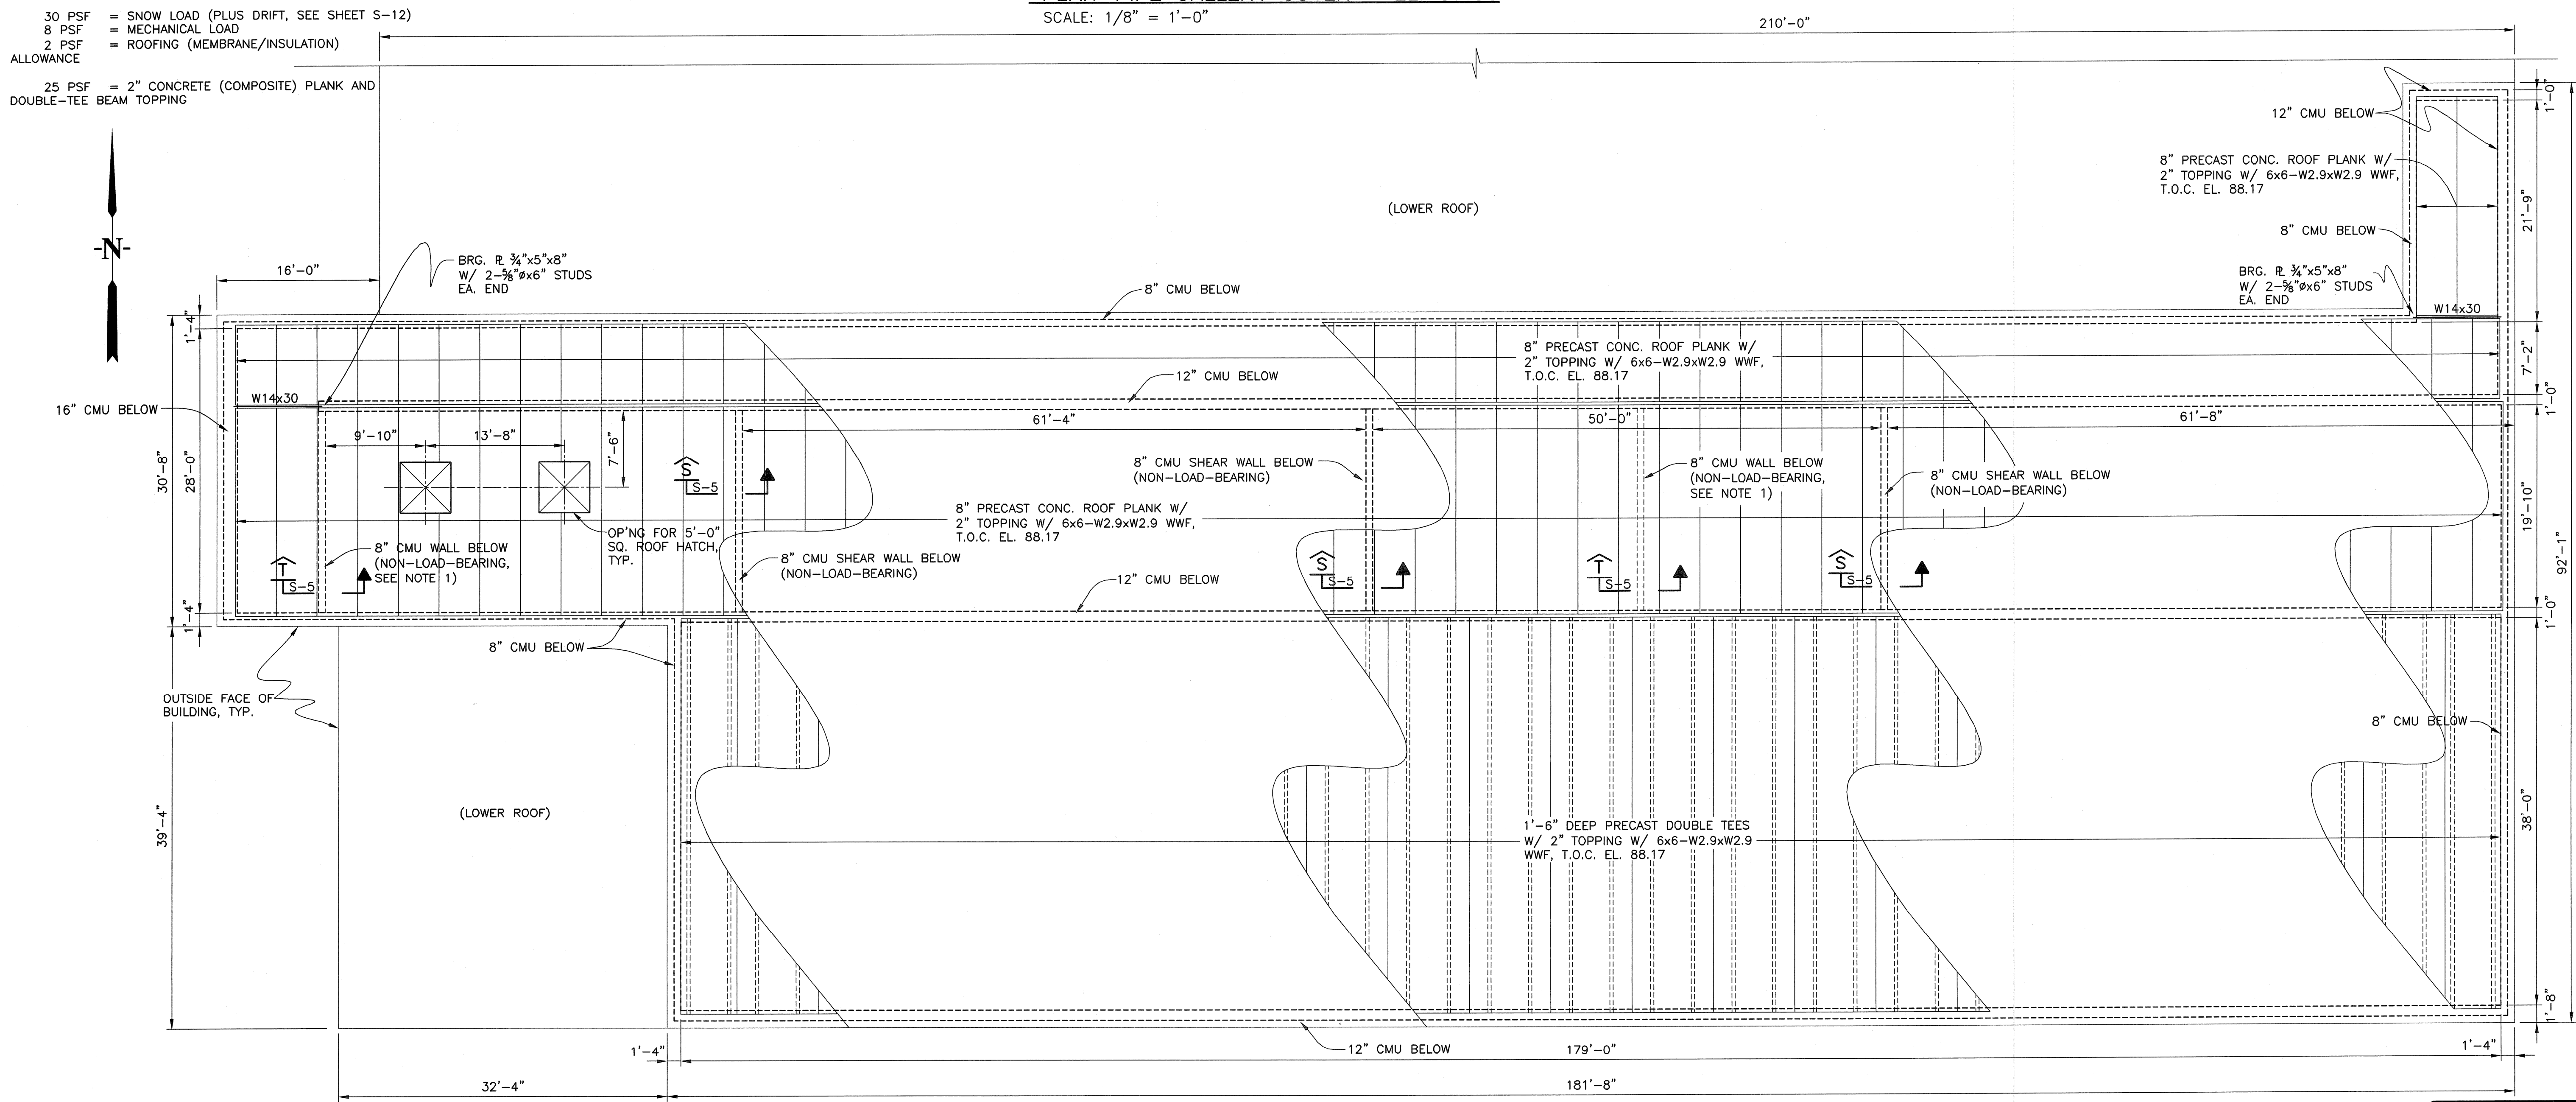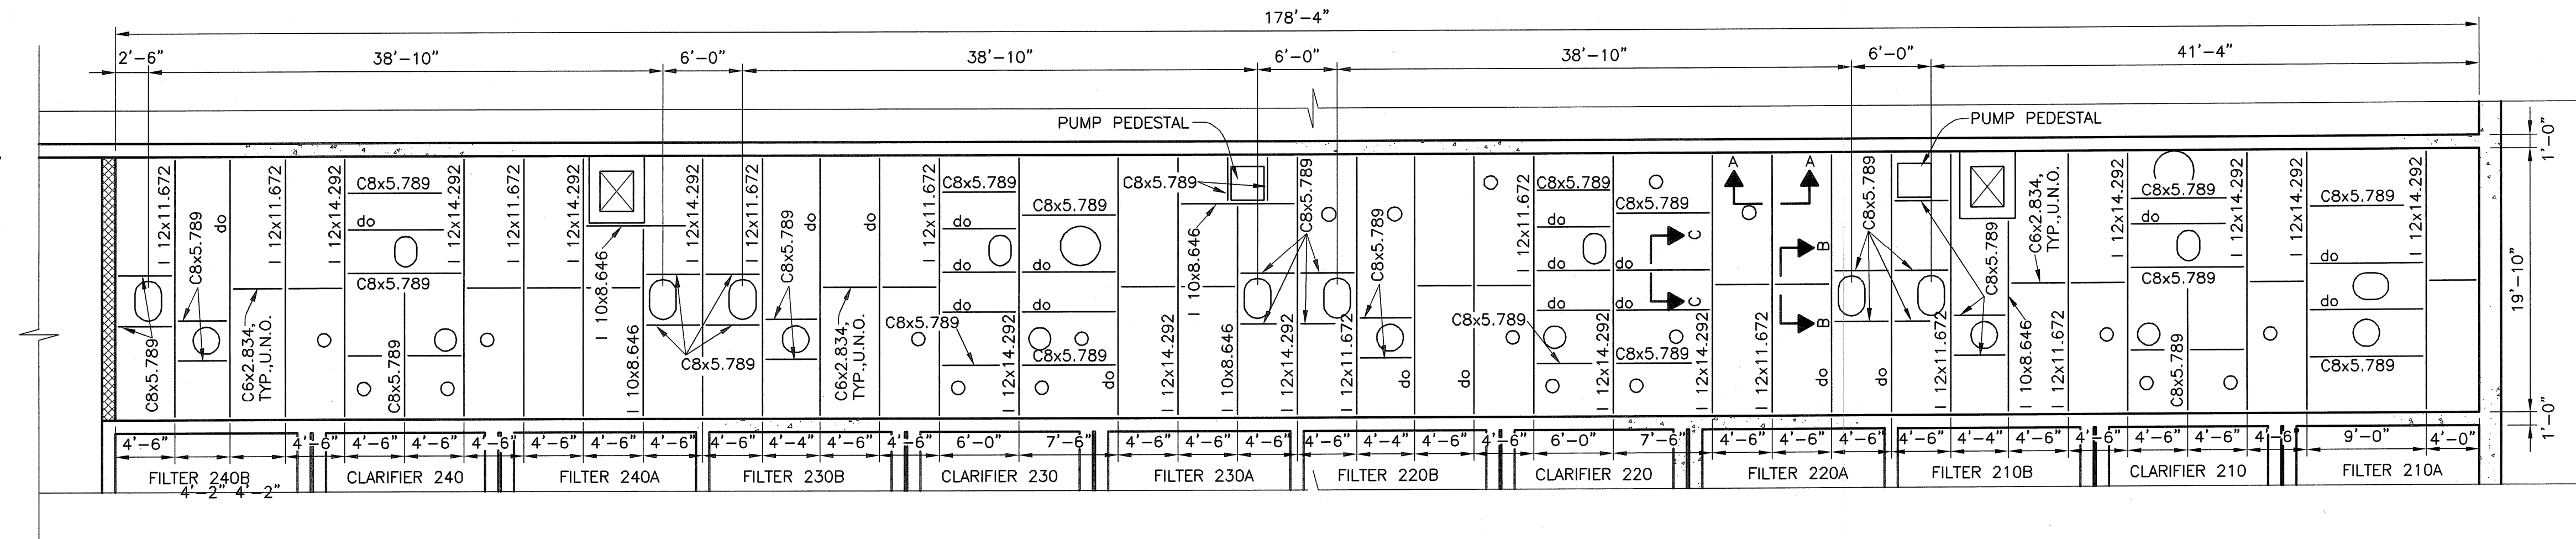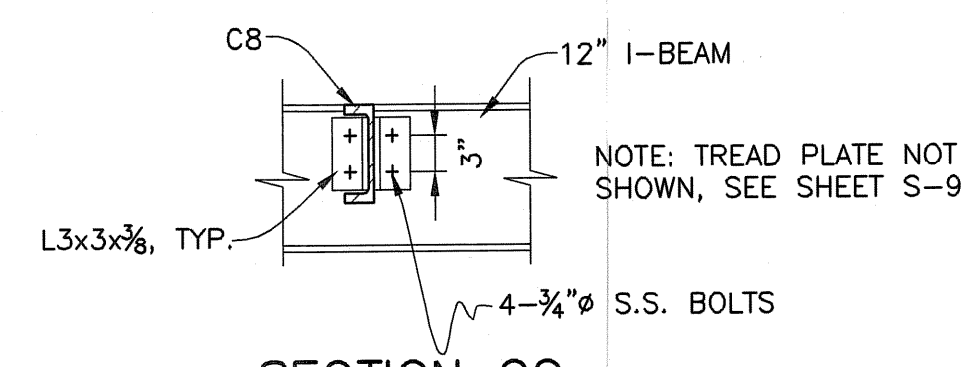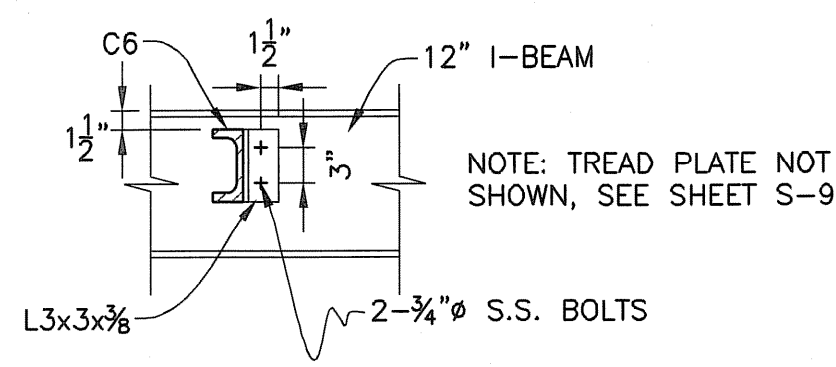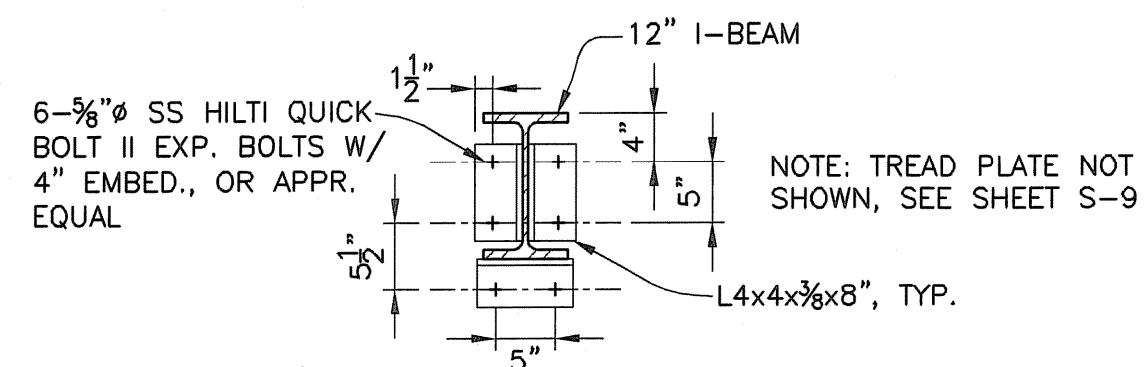

File name: L:\WORK\69993\CAD\AS-BUILT\9) WTP\STRUC\69993S3-5-11-12.DWG
 Plot File Date Created: Aug/11/2008 4:01 PM

2	AS-BUILT DRAWING FILE	DPB	JULY 2008
1	ISSUED FOR POSTED SET	R.D.	10/31/08
0	ISSUED FOR CONSTRUCTION	R.D.	4/05
	REVISIONS	BY	DATE


ROBERT H. SHIELDON
 No. 4103

PAWTUCKET, RHODE ISLAND
PAWTUCKET REGIONAL WATER TREATMENT FACILITY
PKG 9 - UPPER CONCRETE
 PIPE GALLERY COVER PLAN - EL. 57.50
 AND UPPER ROOF PLAN - EL. 88.17

DESIGNED BY	MWC	DWG SCALE	1/8" = 1'-0"
DRAWN BY	MWC	CONTRACT NO.	
CHECKED BY	R.D.	DATE	OCTOBER 31, 2008

EARTH TECH
AS-BUILT FILE
 JULY 2008

Filename: L:\WORK\69993\CAD\AS-BUILT\9) WTP\STRUC\69993S3-5-11-12.DWG
 Plot File Date Created: Aug/11/2008 4:31 PM

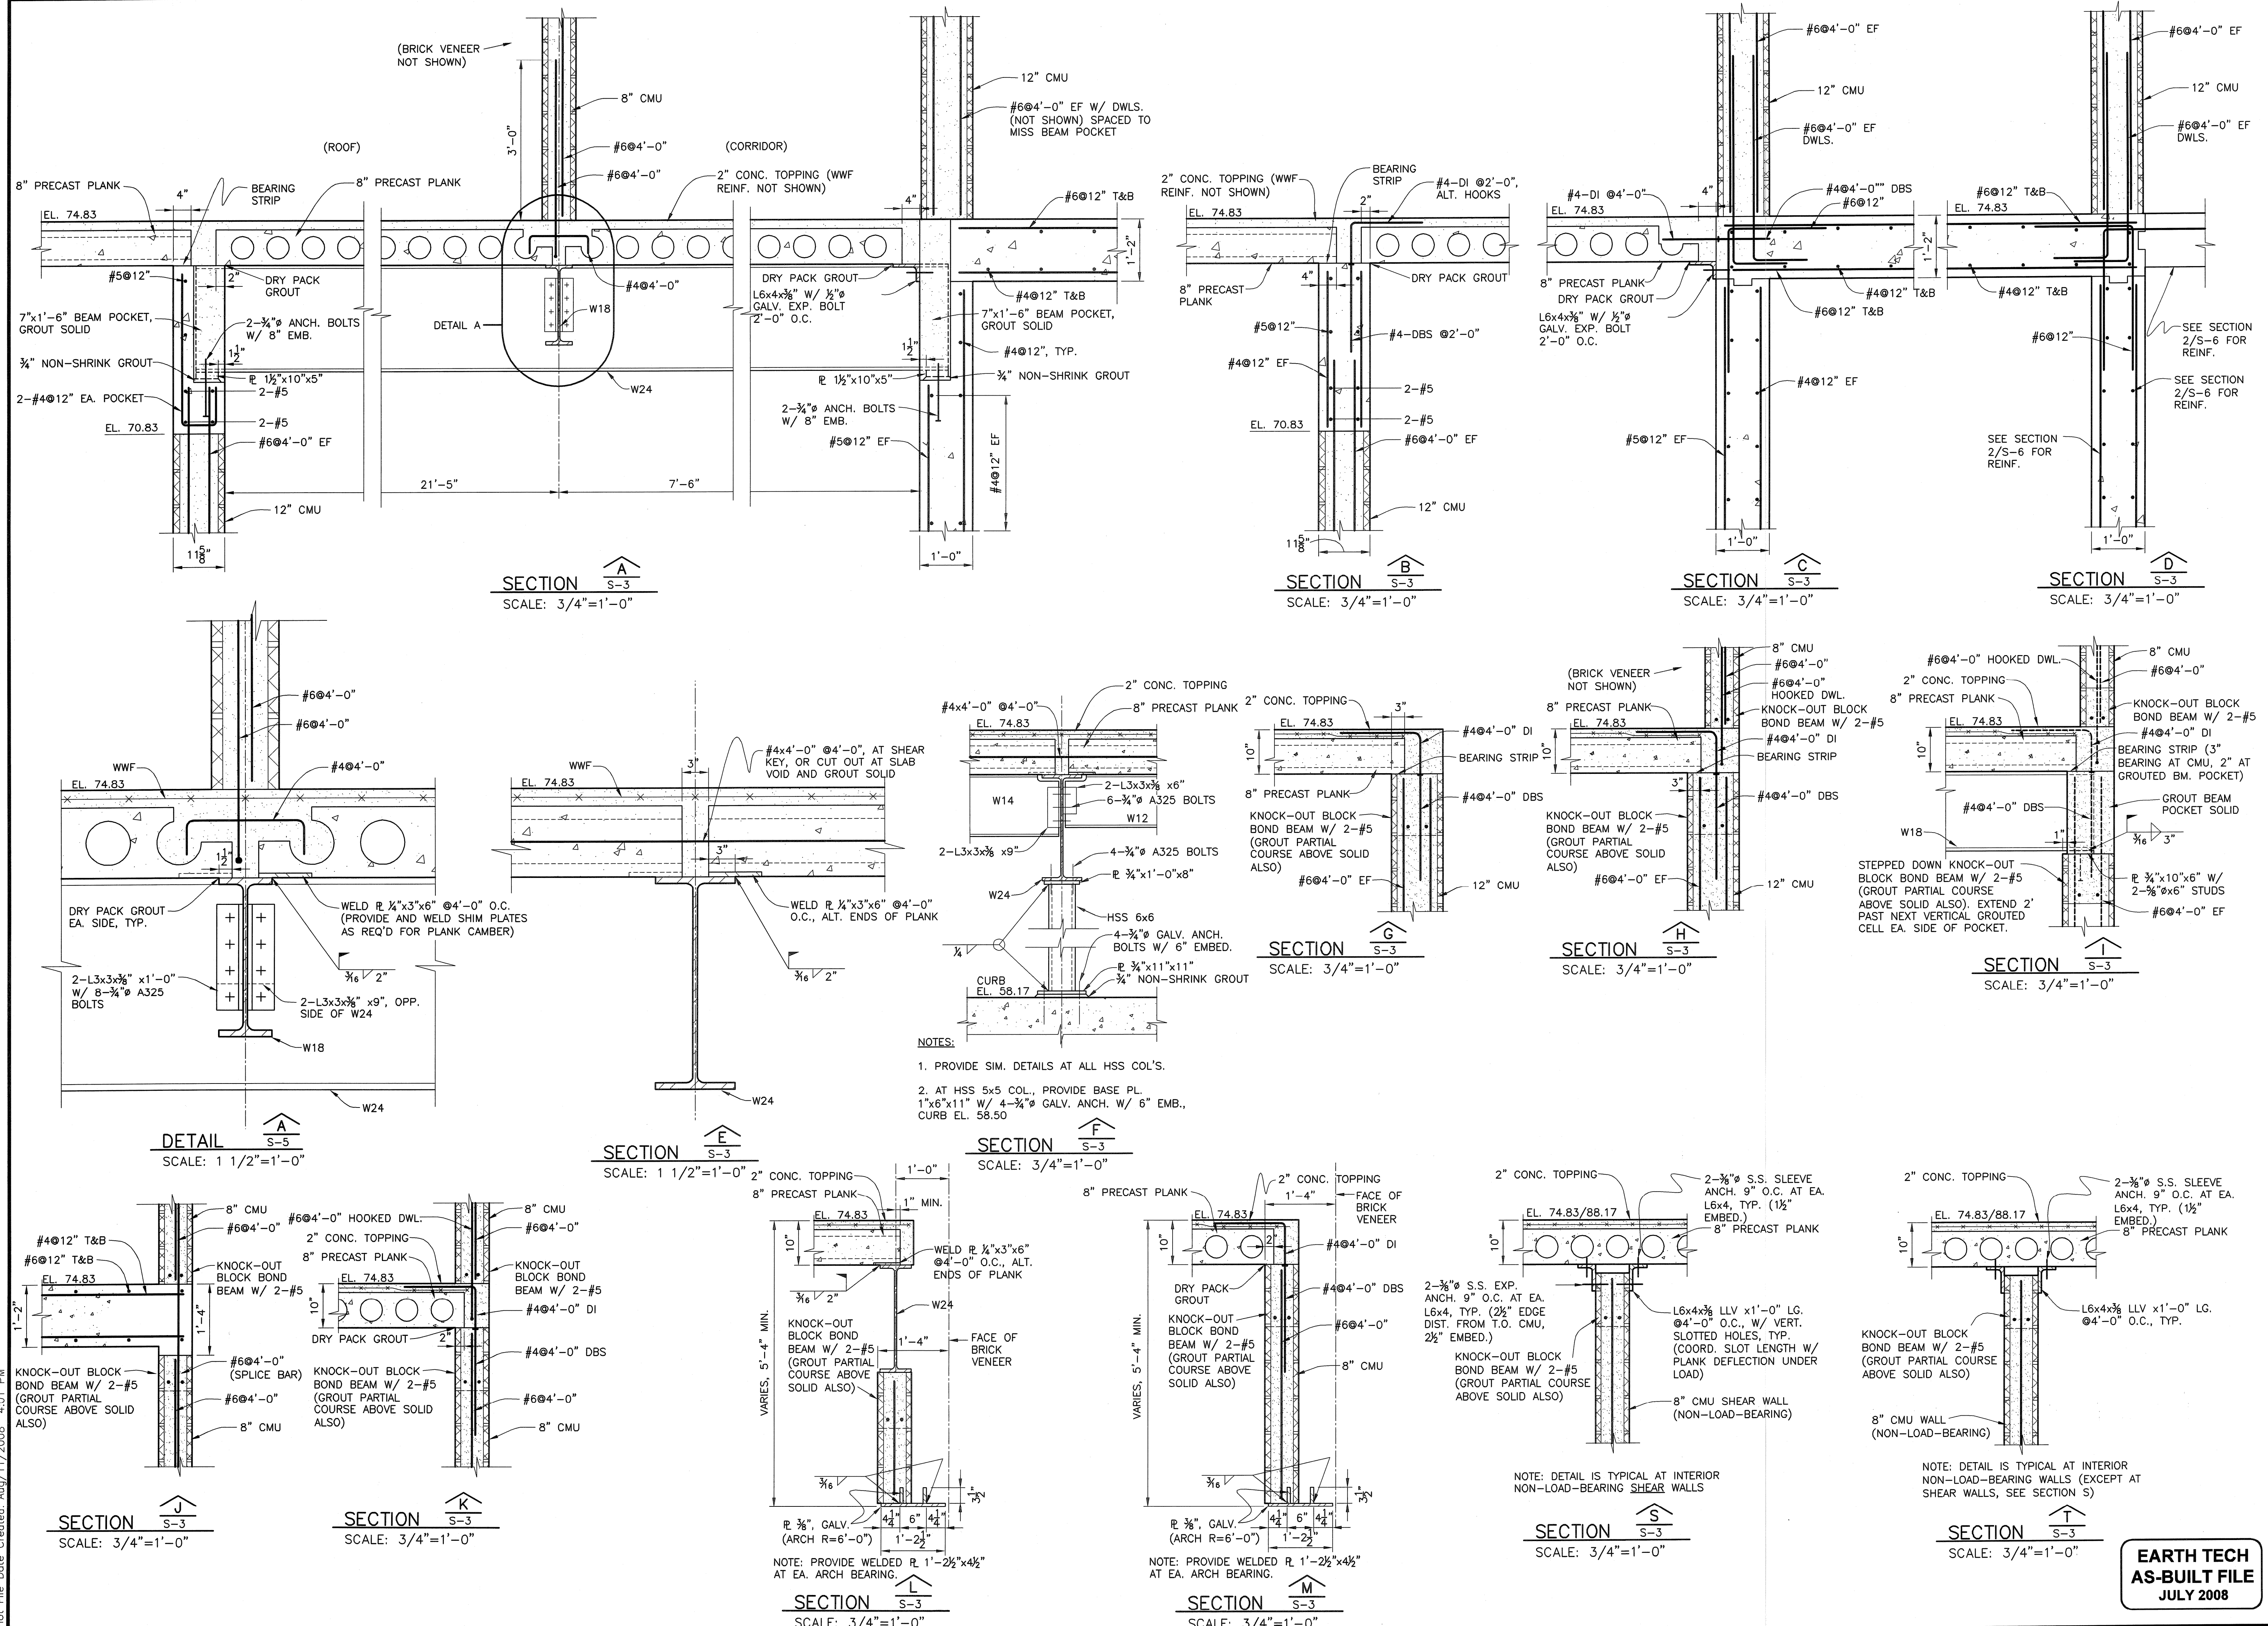

- NOTES:**
1. PROVIDE SIM. DETAILS AT ALL HSS COL'S.
 2. AT HSS 5x5 COL., PROVIDE BASE PL. 1"x6"x11" W/ 4-3/4" GALV. ANCH. W/ 6" EMB., CURB EL. 58.50

EARTH TECH
 AS-BUILT FILE
 JULY 2008

PAWTUCKET, RHODE ISLAND
 PAWTUCKET REGIONAL
 WATER TREATMENT FACILITY
PKG 9 - UPPER CONCRETE

SECTIONS AND DETAILS

DESIGNED BY	MWC	DWG SCALE	AS NOTED
DRAWN BY	MWC	CONTRACT NO.	CONTRACT
CHECKED BY	R.D.	DATE	OCTOBER 31, 2008


AS-BUILT DRAWING FILE	DPB JULY 2008	ISSUED FOR RFI POSTED SET	R.D. 10/31/08
ISSUED FOR CONSTRUCTION	R.D. 4/05	REVISIONS	BY DATE
NO.			

S-5

SHEET OF

EarthTech
 A Tyco International Ltd. Company
 300 BAKER AVENUE SUITE 280 CONCORD MA 01742 (978) 371-4000

Filename: L:\WORK\69933\CAD\AS-BUILT\9) WTP\STRUC\69933S-6.DWG
 Plot File Date Created: Aug/11/2008 4:04 PM

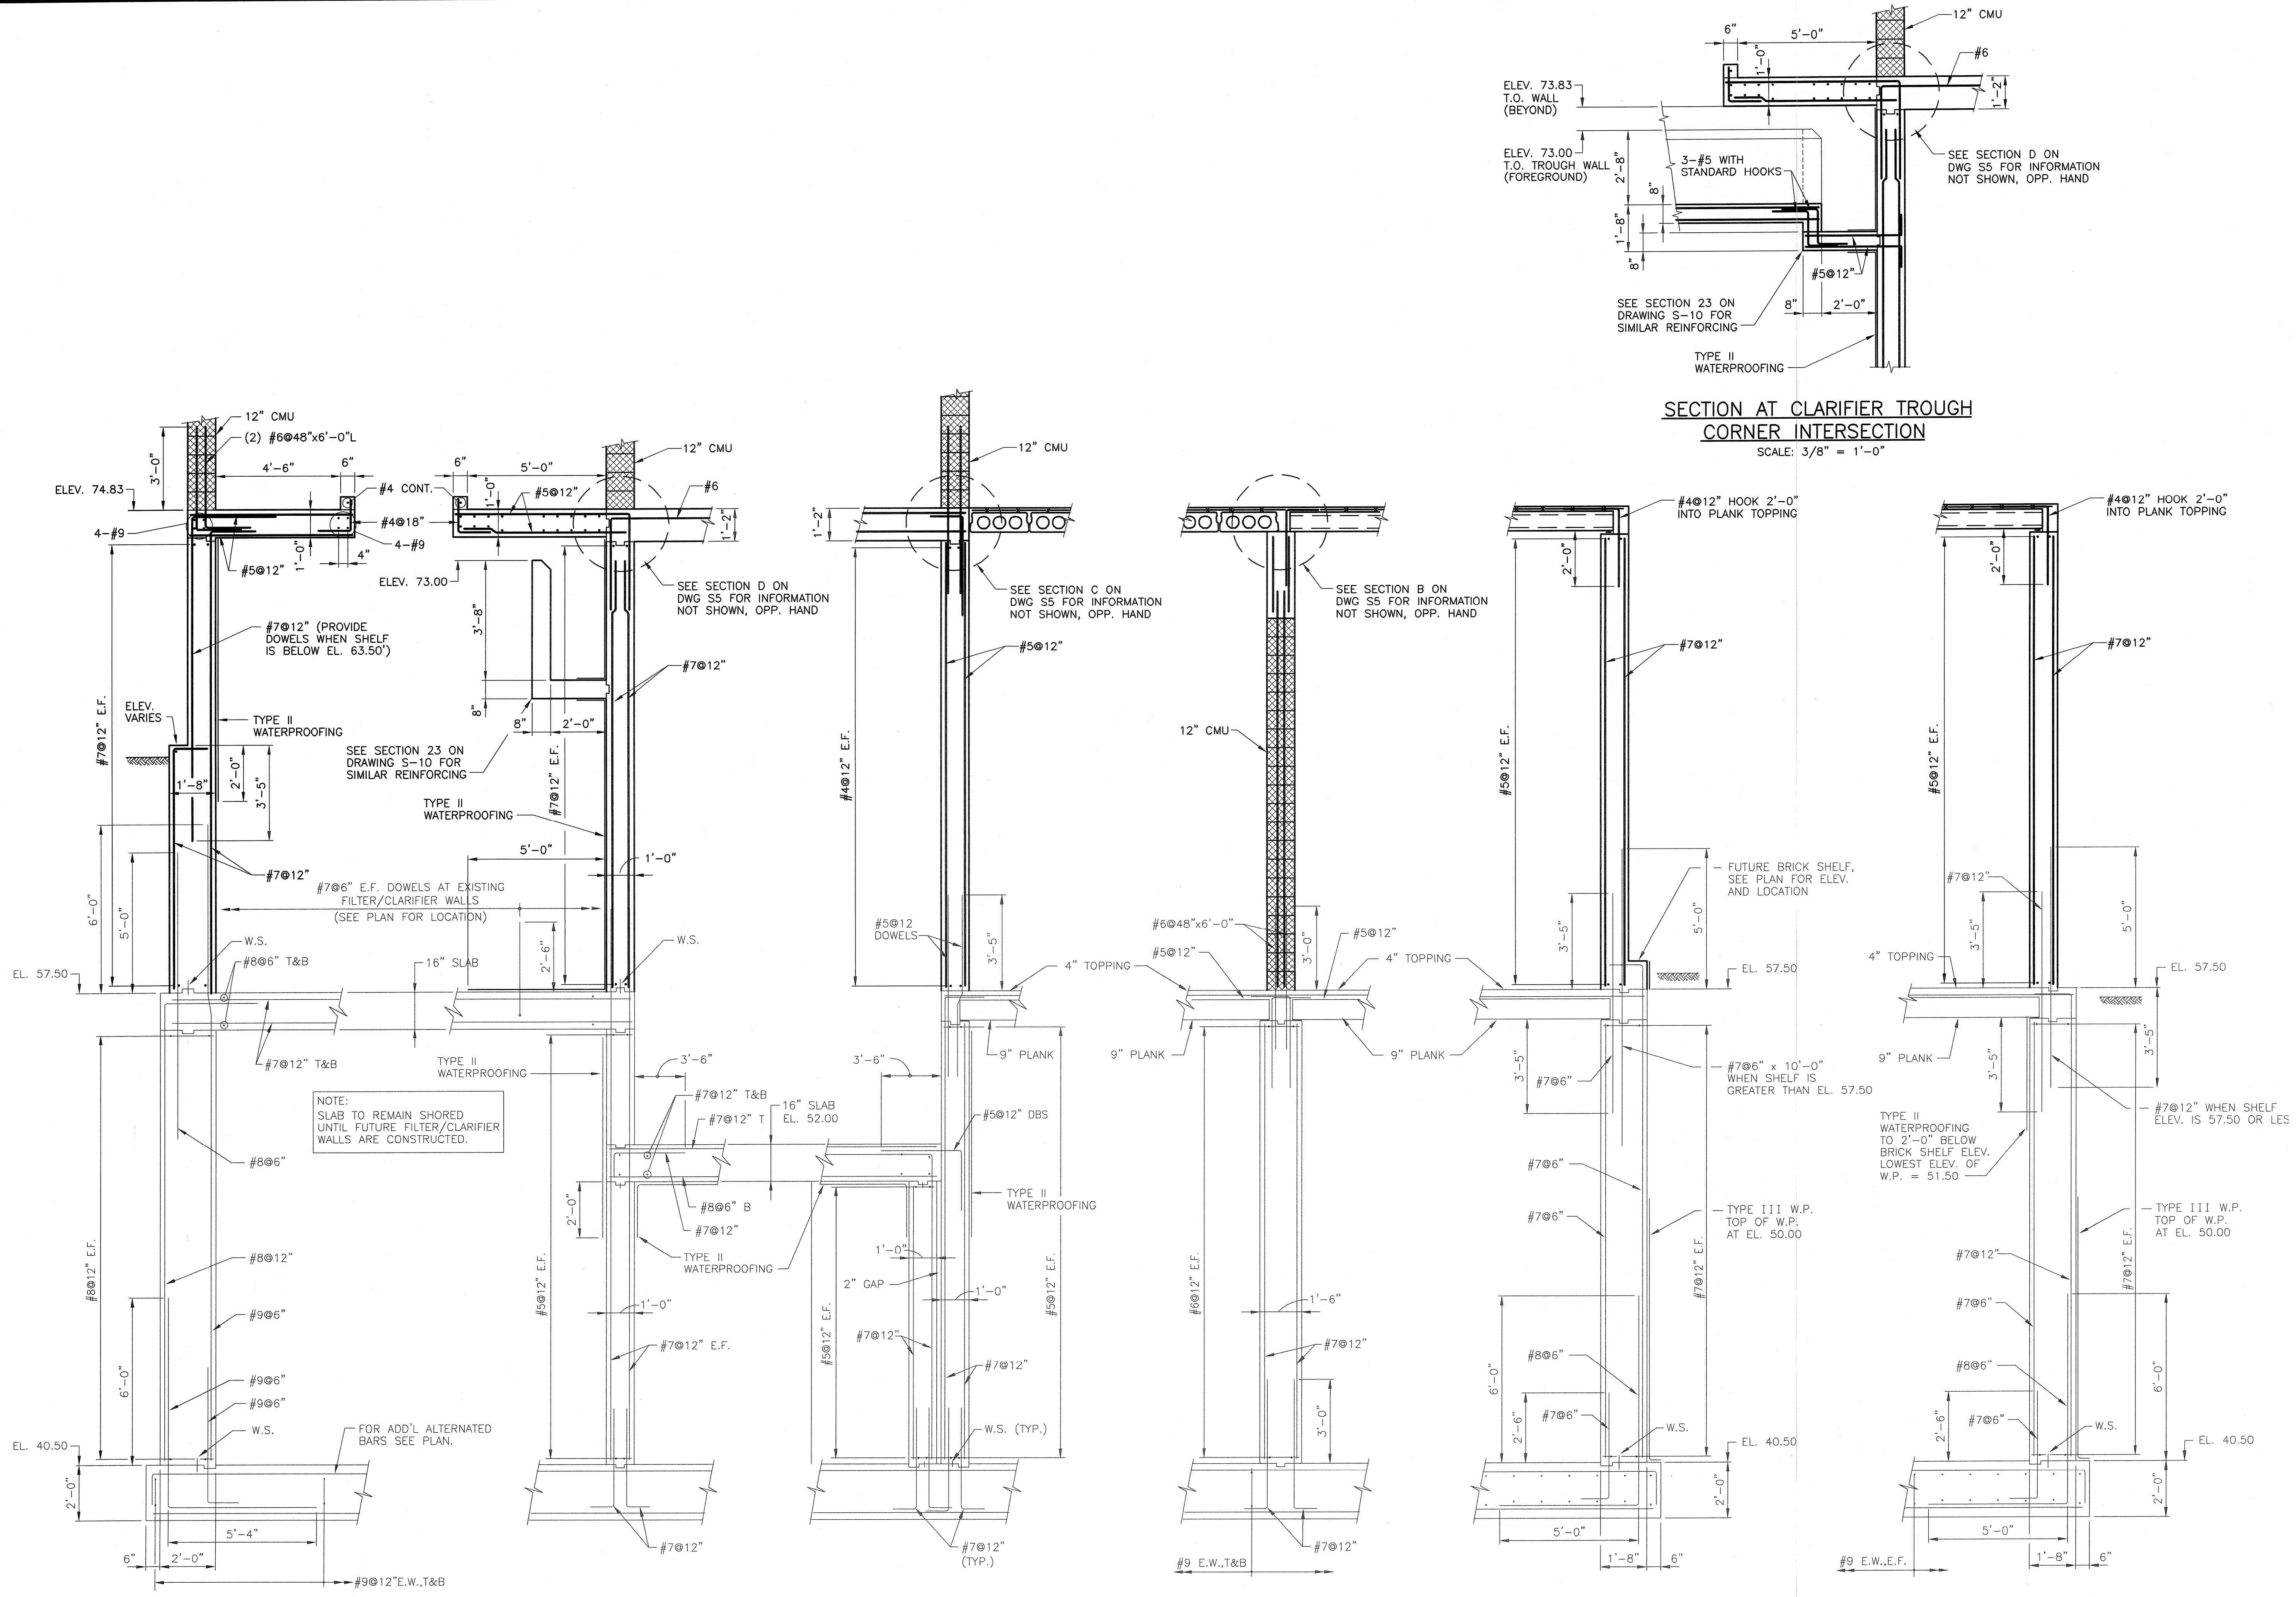

**SECTION AT CLARIFIER TROUGH
 CORNER INTERSECTION**
 SCALE: 3/8" = 1'-0"

SECTION 1
 S-2, S-3
 SCALE: 3/8" = 1'-0"

SECTION 2
 S-2, S-3
 SCALE: 3/8" = 1'-0"

SECTION 3
 S-2, S-3
 SCALE: 3/8" = 1'-0"

SECTION 4
 S-2, S-3
 SCALE: 3/8" = 1'-0"

SECTION 5
 S-2, S-3
 SCALE: 3/8" = 1'-0"

SECTION 6
 S-2, S-3
 SCALE: 3/8" = 1'-0"

EARTH TECH
AS-BUILT FILE
JULY 2008

FULL SIZE DRAWING = 4"	
NO.	REVISIONS
0	ISSUED FOR CONSTRUCTION
1	ISSUED FOR RE POSTED SET
2	AS-BUILT DRAWING FILE
DRB	DATE
DRB	JULY 2008


ROBERT H. SHELDON
 No. 4103
 REGISTERED PROFESSIONAL ENGINEER

PAWTUCKET, RHODE ISLAND
**PAWTUCKET REGIONAL
 WATER TREATMENT FACILITY**
PKG 9 - UPPER CONCRETE
 SECTIONS AND DETAILS


DESIGNED BY	DWG SCALE
DRB	3/8" = 1'-0"
CHECKED BY	CONTRACT NO.
DATE	
OCTOBER 31, 2008	

S-6
 SHEET OF

Filename: L:\WORK\69993\CAD\AS-BUILT\9) WTP\STRUC\69993S-7.DWG
 Plot File Date Created: Aug/11/2008 4:05 PM

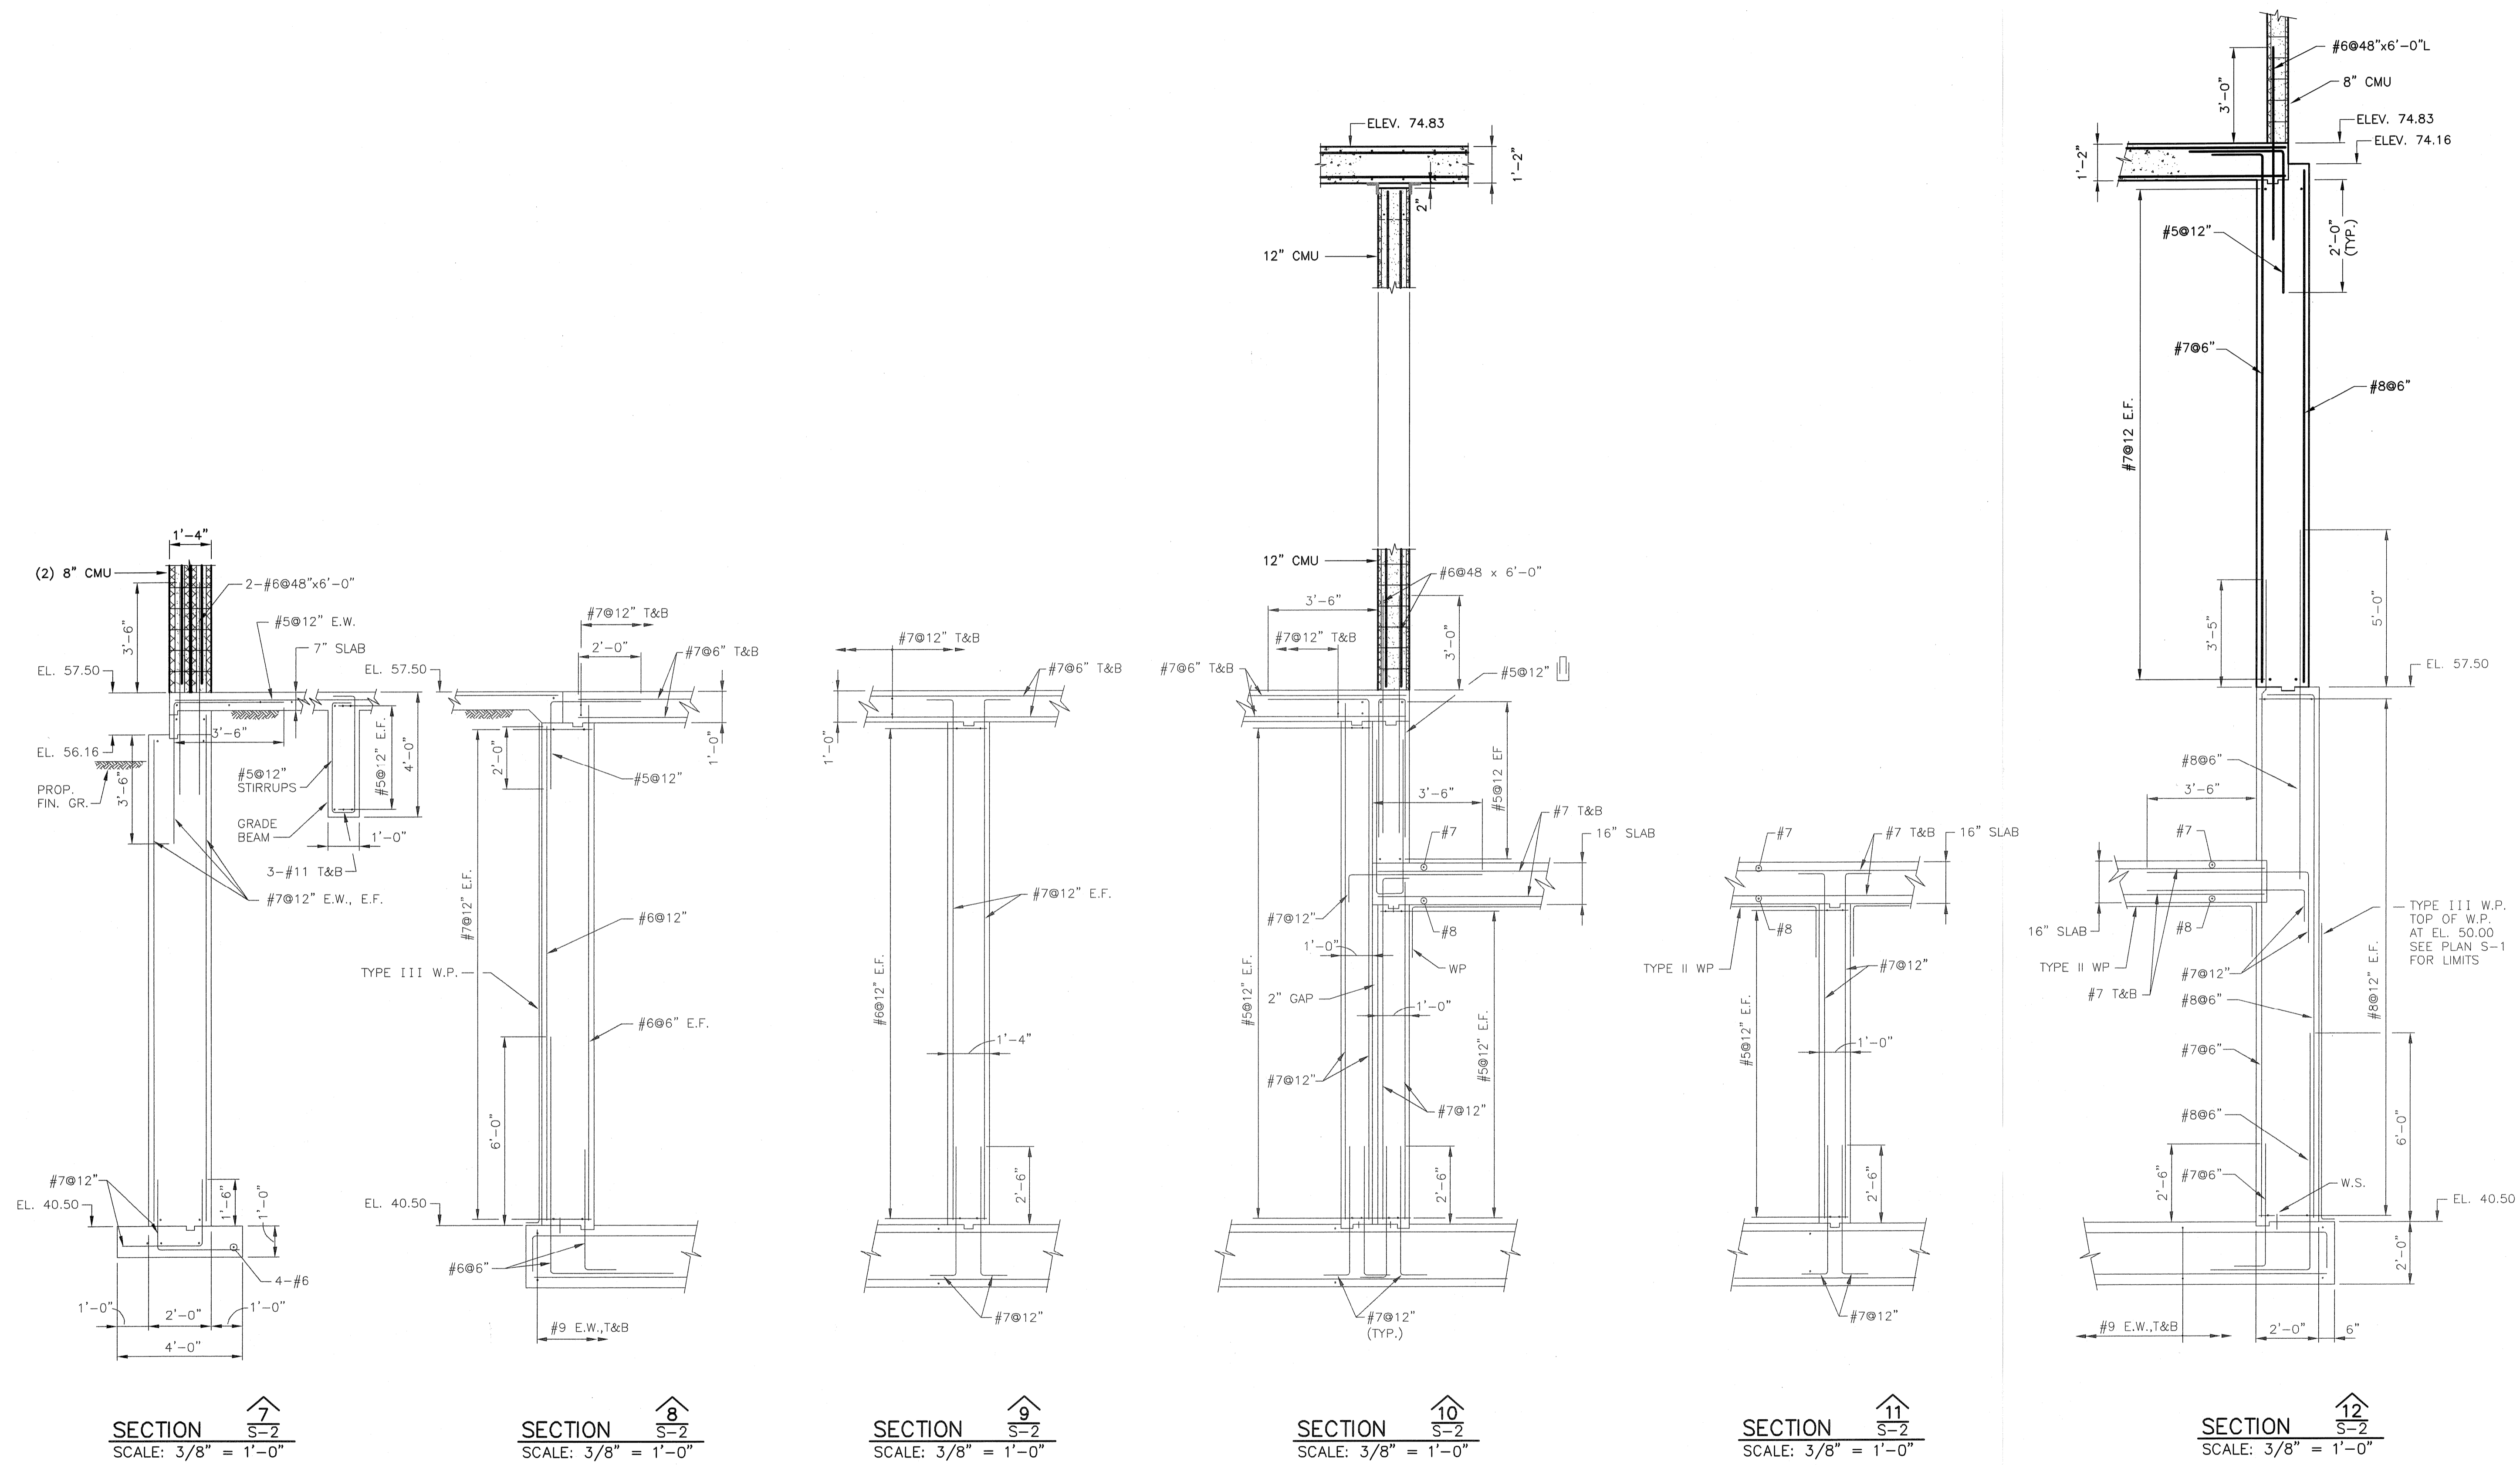

FULL SIZE DRAWING = 4"	
AS-BUILT DRAWING FILE	DPB JULY 2008
ISSUED FOR RFI POSTED SET	R.D. 10/31/06
ISSUED FOR CONSTRUCTION	R.D. 4/05
REVISIONS	BY DATE
1	
0	

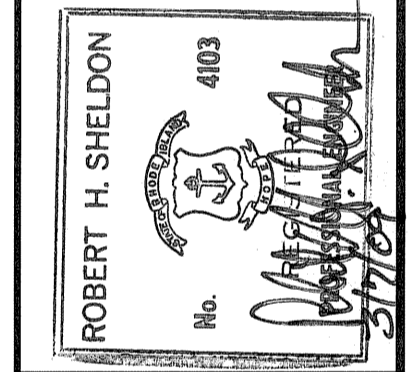


PAWTUCKET, RHODE ISLAND
**PAWTUCKET REGIONAL
 WATER TREATMENT FACILITY**
PKG 9 - UPPER CONCRETE
 SECTIONS AND DETAILS


DESIGNED BY	DWG SCALE
DPB	3/8" = 1'-0"
CHECKED BY	CONTRACT NO.
	DATE
	OCTOBER 31, 2006

EARTH TECH
 AS-BUILT FILE
 JULY 2008


Filename: L:\WORK\69933\CAD\AS-BUILT\9) WTP\STRUC\69933S-8.DWG
 Plot File Date Created: Aug/11/2008 4:06 PM

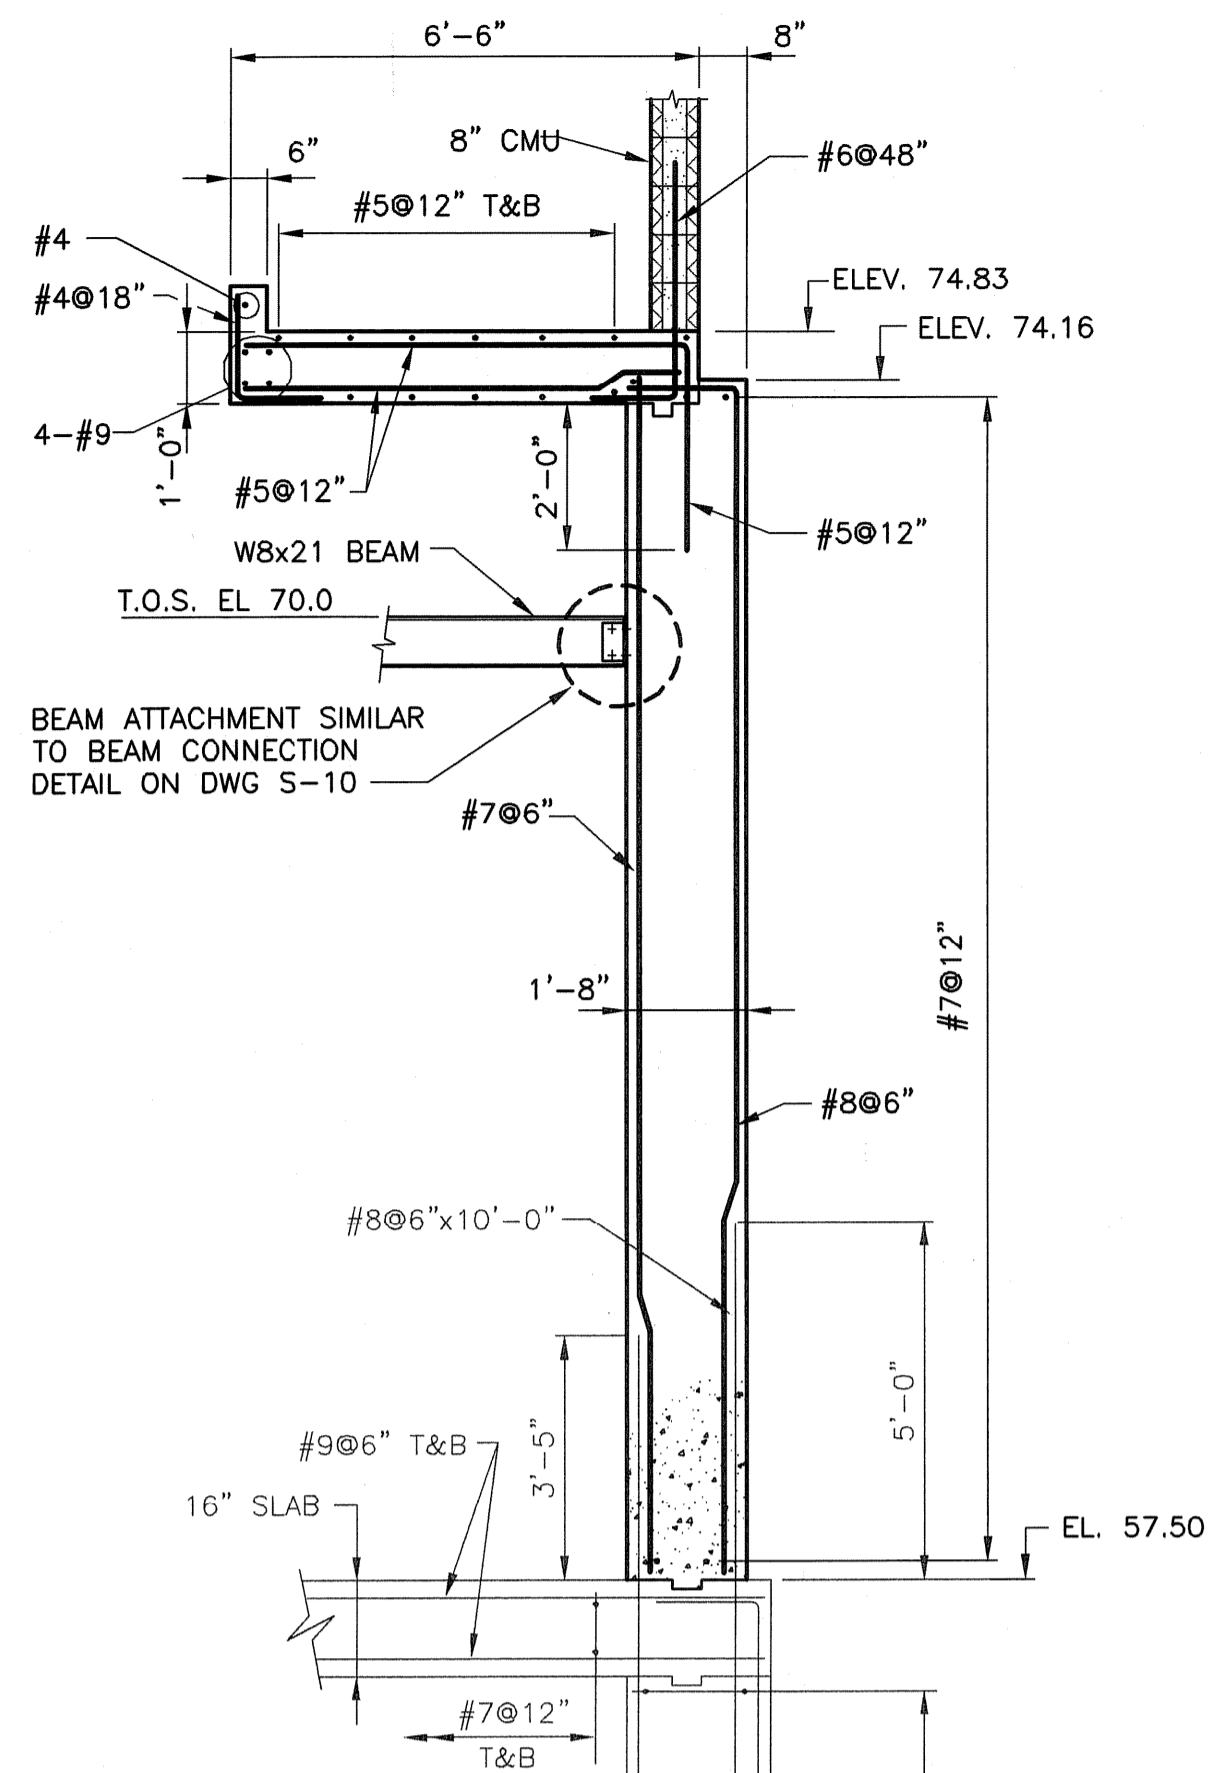


SECTION 13
 S-2
 SCALE: 3/8" = 1'-0"

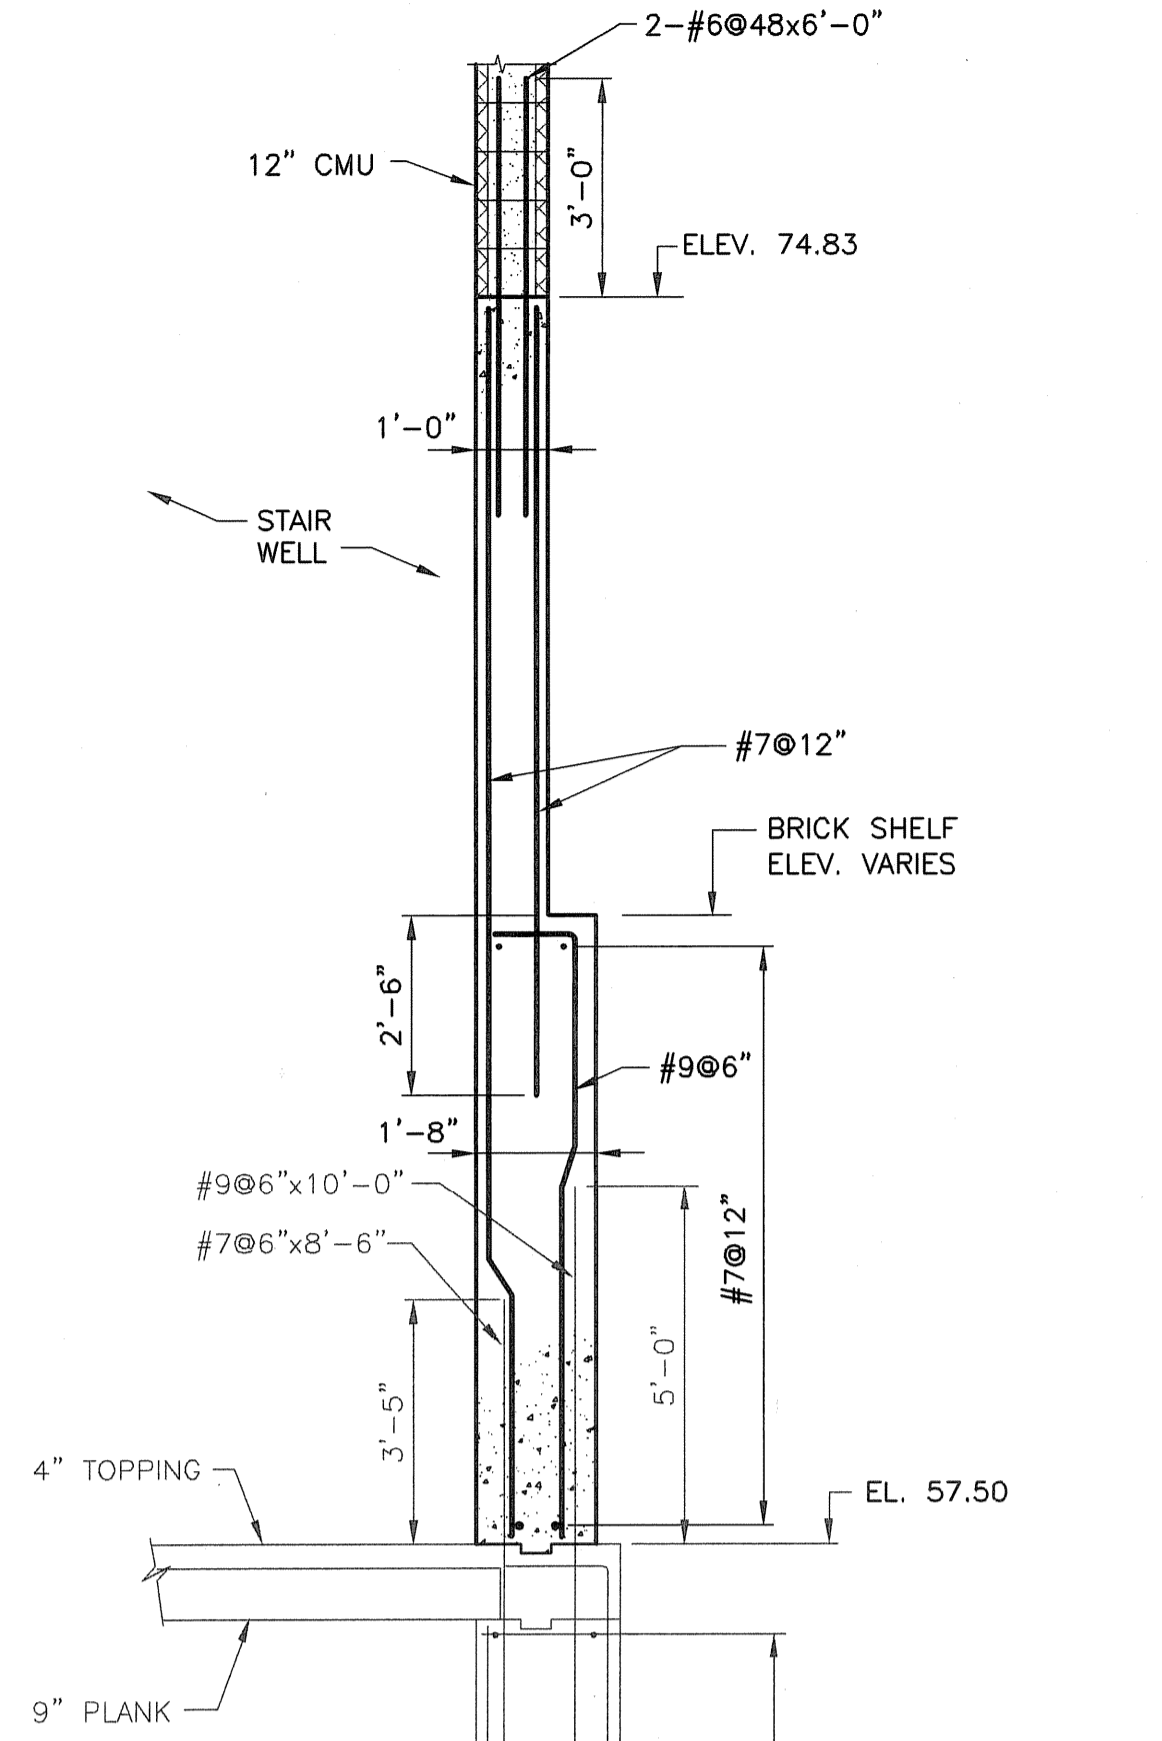


SECTION 14
 S-2
 SCALE: 3/8" = 1'-0"

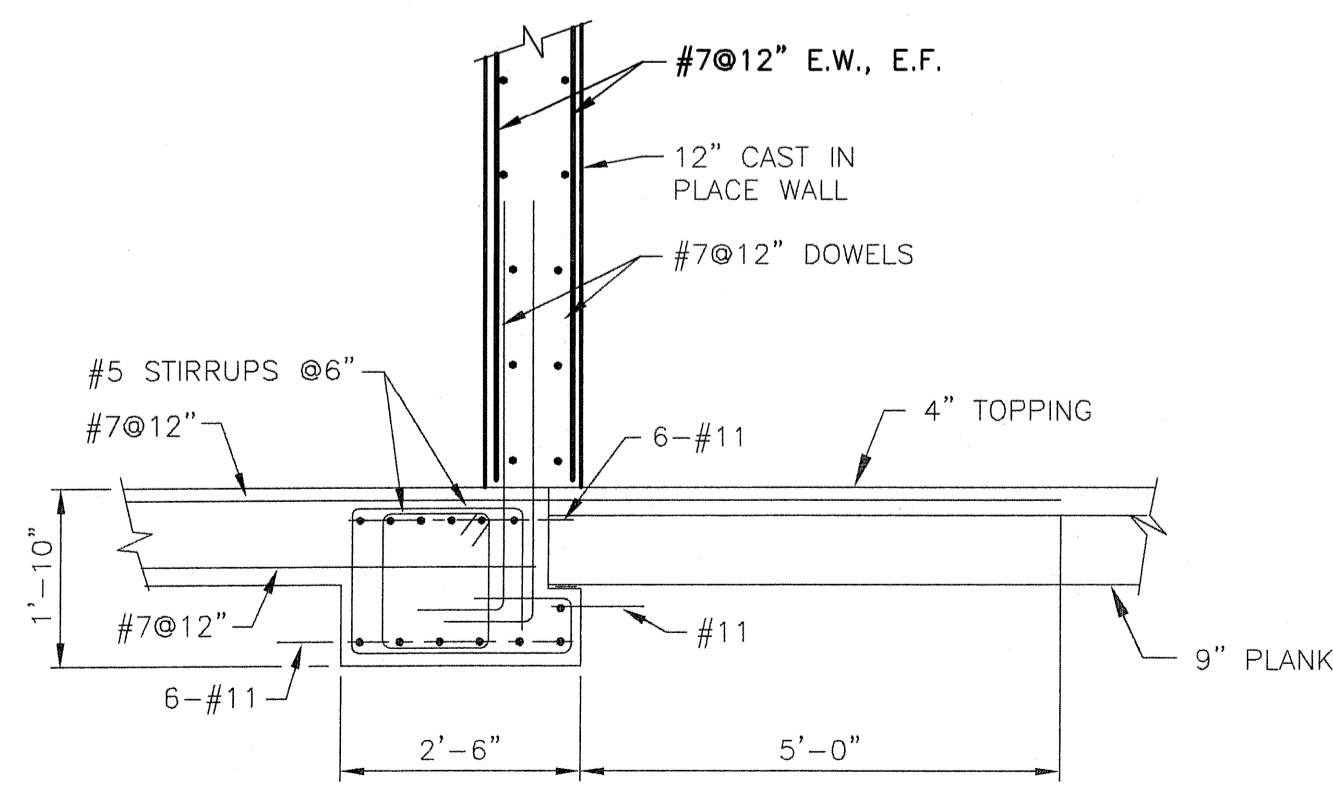


SECTION 15
 S-2
 SCALE: 1/2" = 1'-0"

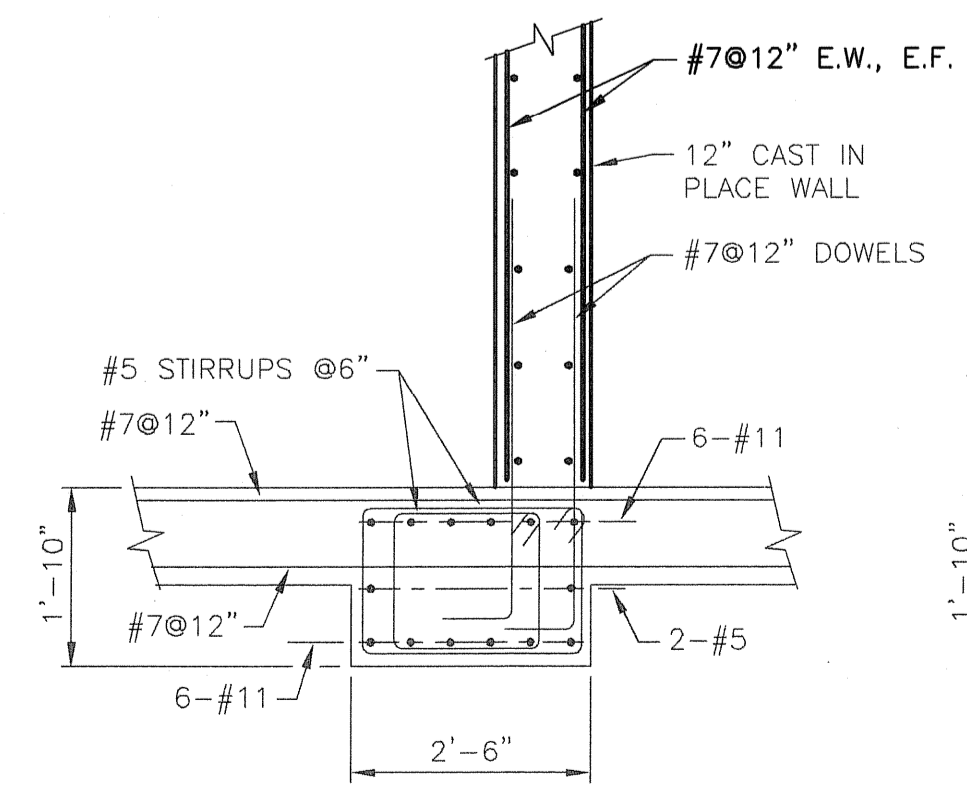


SECTION 16
 S-2
 SCALE: 1/2" = 1'-0"

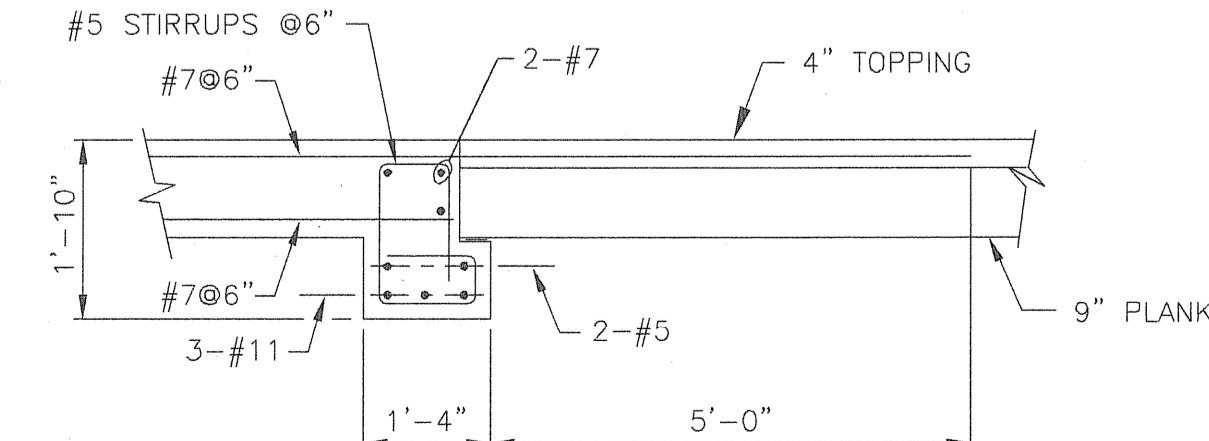

SECTION 17
 S-2
 SCALE: 1/2" = 1'-0"

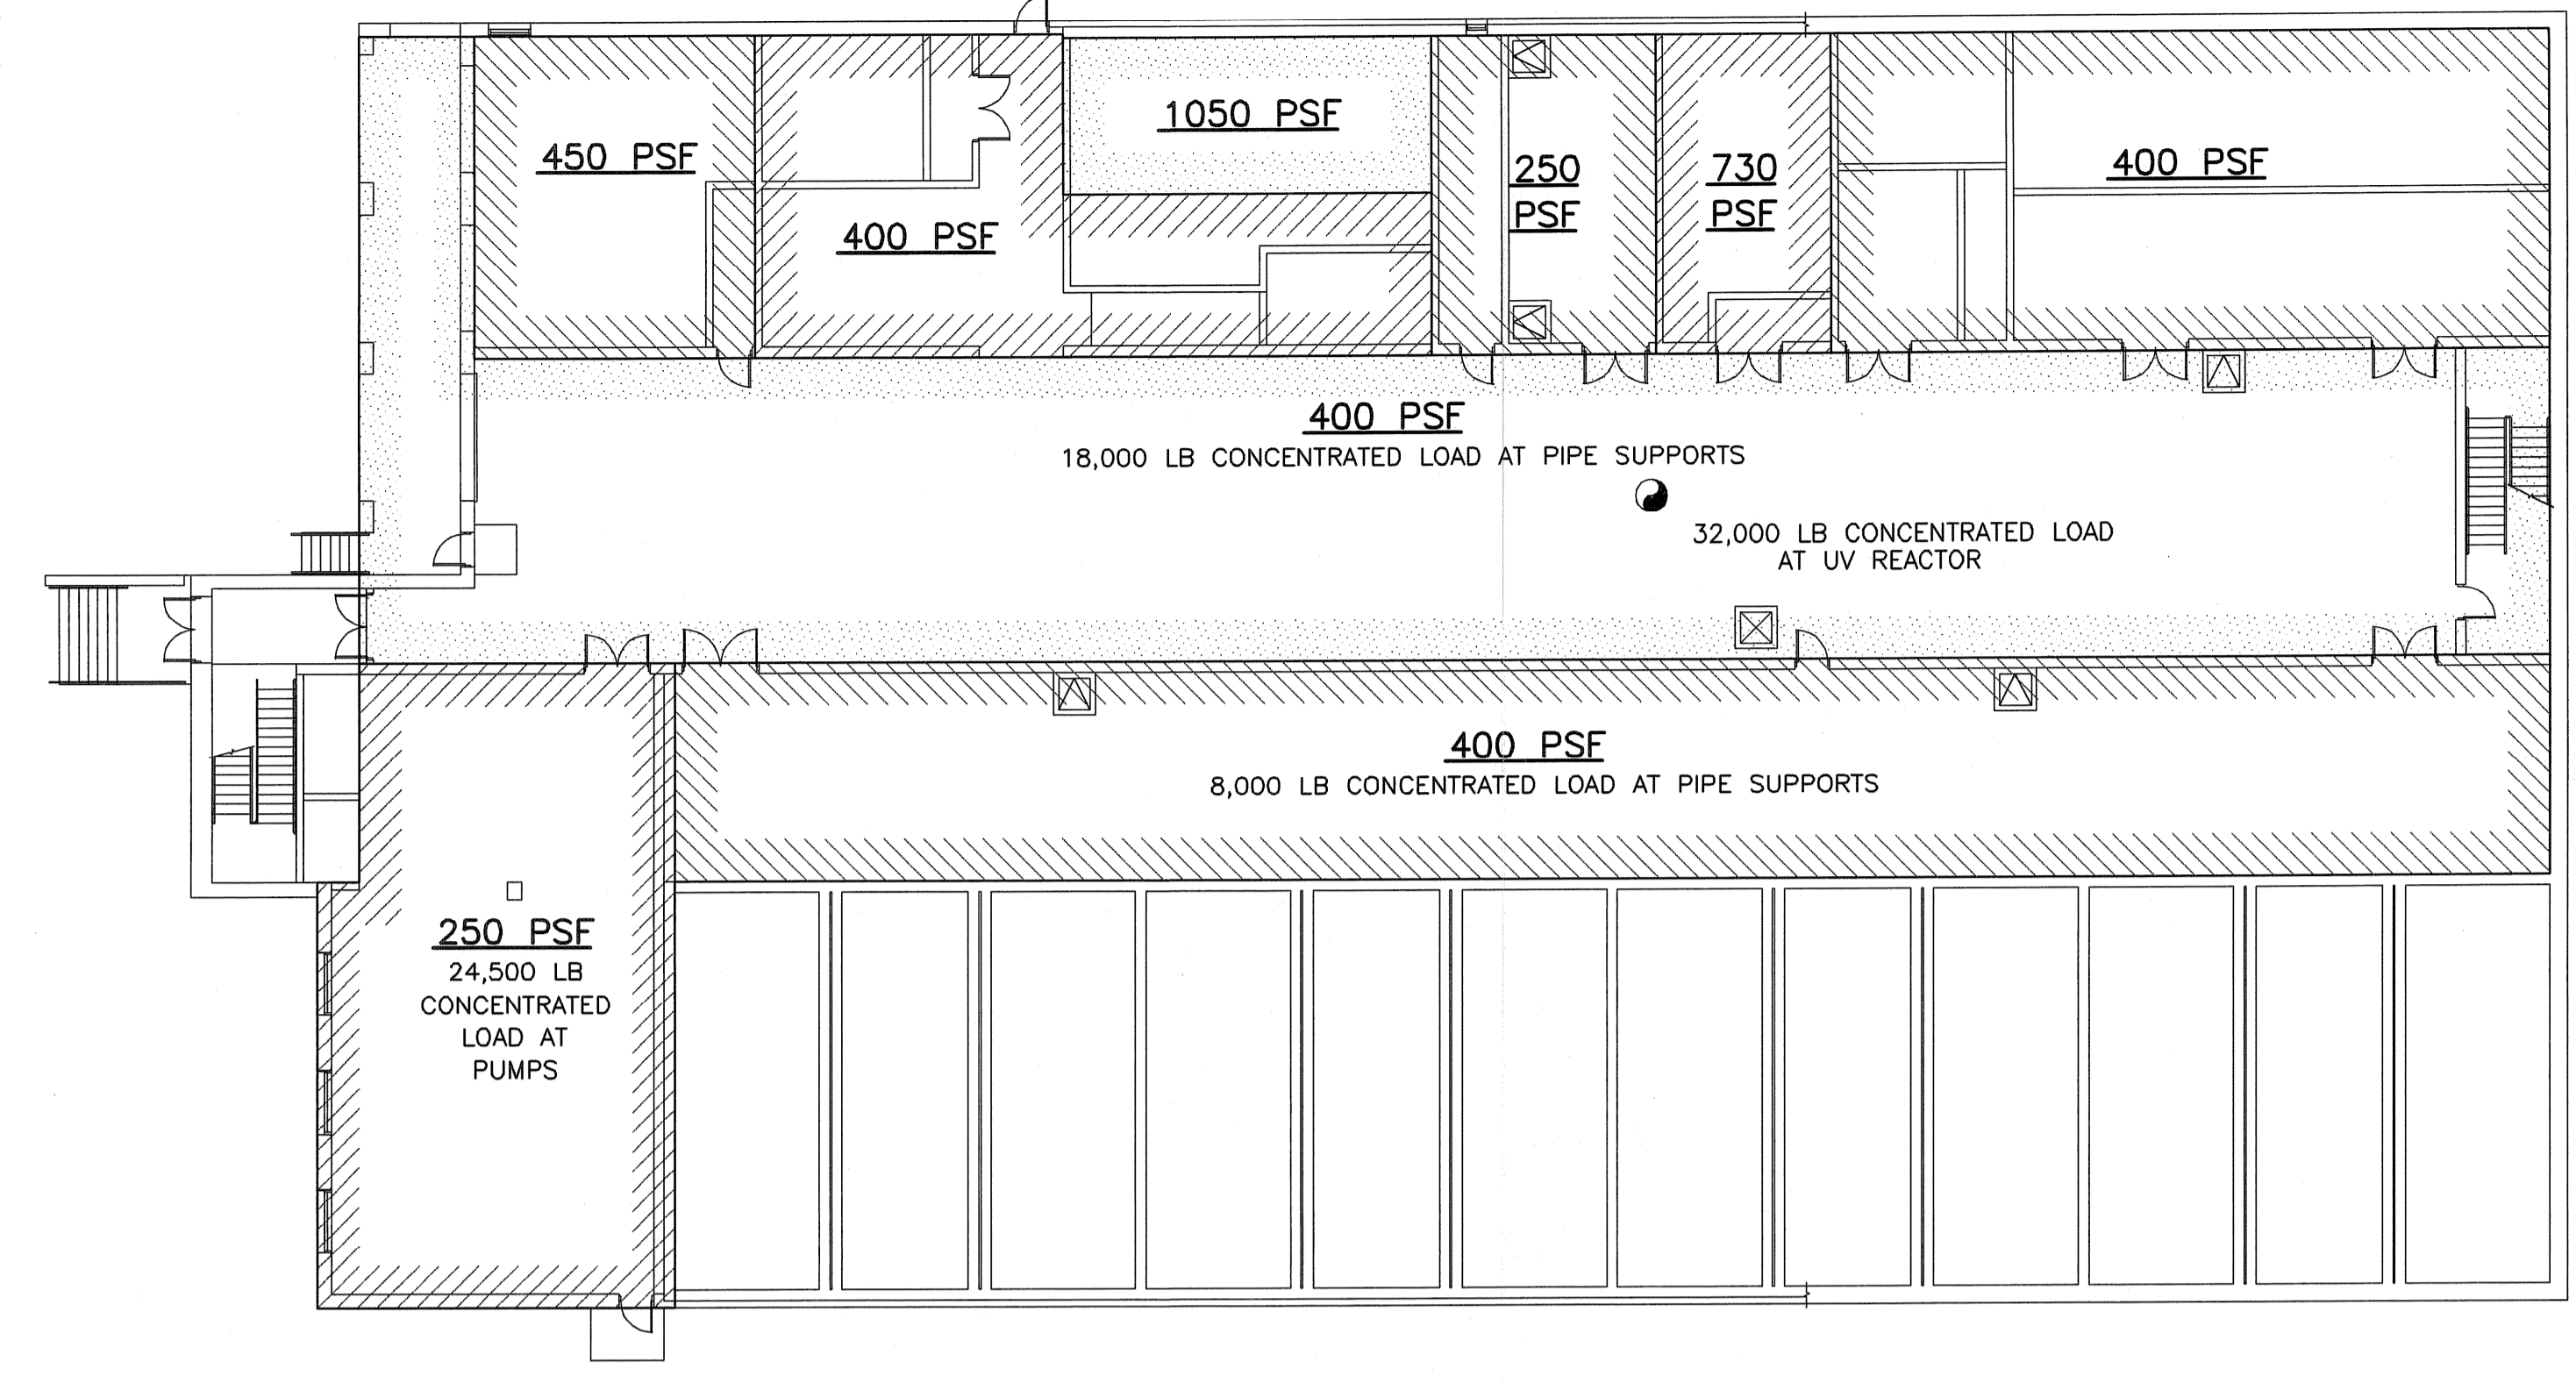

DESIGN LIVE LOAD DIAGRAM AT FLOOR EL. 57.50
 SCALE: 1/16" = 1'-0"

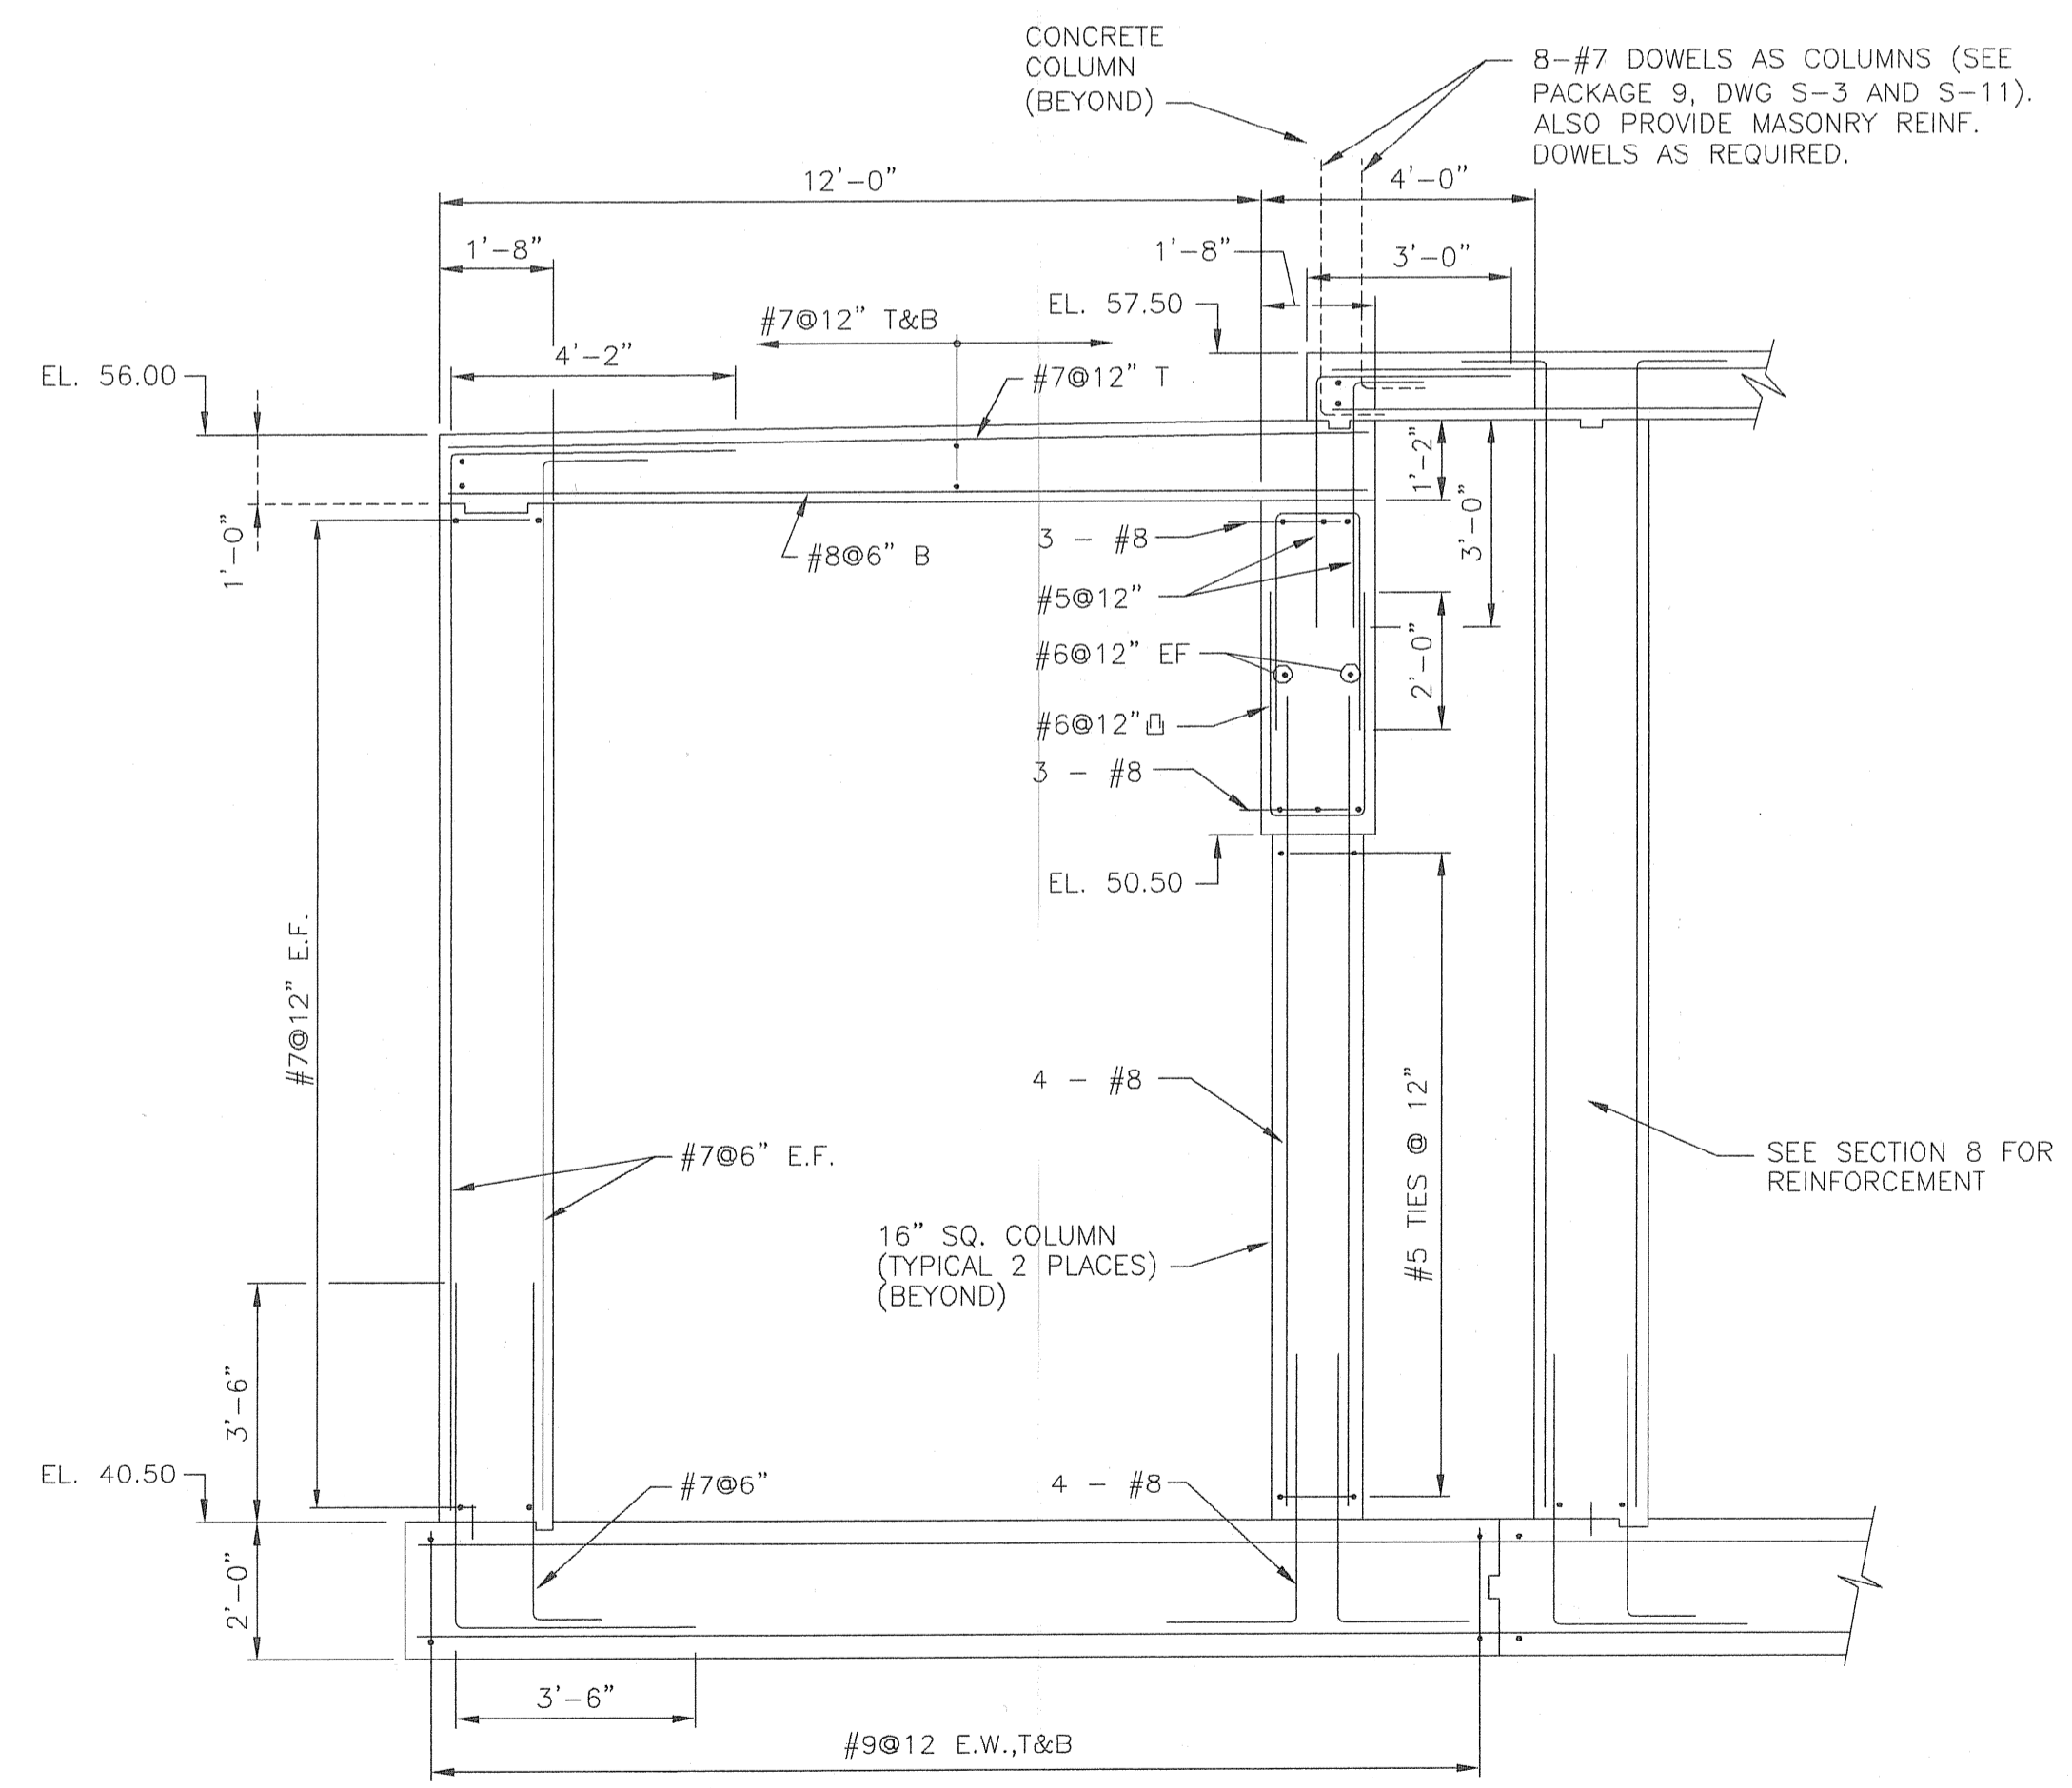

SECTION 18
 S-2
 SCALE: 3/8" = 1'-0"

EARTH TECH
 AS-BUILT FILE
 JULY 2008

NO.	REV.	DATE	REVISIONS
2	AS-BUILT DRAWING FILE	08 JULY 2008	
1	ISSUED FOR RFI POSTED SET	10/31/06	
0	ISSUED FOR CONSTRUCTION	4/05	

ROBERT H. SHELDON
 No. 4103
 REGISTERED PROFESSIONAL ENGINEER
 STATE OF MASSACHUSETTS
 5/17/08

PAWTUCKET, RHODE ISLAND
 PAWTUCKET REGIONAL
 WATER TREATMENT FACILITY
 PKG 9 - UPPER CONCRETE
 SECTIONS AND DETAILS


DESIGNED BY	DWG SCALE
DRAWN BY	CONTRACT NO.
CHECKED BY	DATE
	OCTOBER 31, 2008

CONCRETE PROTECTION FOR REINFORCEMENT (A)				
MEMBER	EXPOSED TO			
	AIR	WEATHER & AIR OVER LIQUID	EARTH & LIQUID	SALT WATER
FOOTING	—	—	2"(B)	4"
WALL COLUMN BEAM	1 1/2"	2"	2"(B)	3"(B)
SLAB	TOP	1 1/2"(C)	2"	3"
	BOTTOM	3/4"(D)	2"	3"(B)


- (A) APPLICABLE TO ALL CAST-IN-PLACE CONCRETE, EXCEPT AS OTHERWISE SHOWN ON THE DRAWINGS.
 (B) INCREASE 1" WHEN CAST AGAINST EARTH.
 (C) 3/4" WHEN MEMBRANE OR WEARING SURFACE USED.
 (D) 1 1/2" WHERE REQ'D TO CLEAR WATERSTOP.

MINIMUM RE-BAR SPLICE LENGTHS (in.)*		
BAR SIZE	TOP BARS**	OTHER BARS
4	20	16
5	24	18
6	26	20
7	39	30
8	46	35
9	52	40
10	57	44
11	64	49


* THIS TABLE IS BASED ON NORMAL WEIGHT CONCRETE, UNCOATED BARS, CLEAR SPACING NOT LESS THAN FOUR BAR DIAMETERS, AND CLEAR COVER NOT LESS THAN TWO BAR DIAMETERS.
 ** HORIZONTAL BARS WITH MORE THAN 12" OF CONCRETE CAST BELOW THE BARS AS DEFINED BY A.C.I. 318-95.

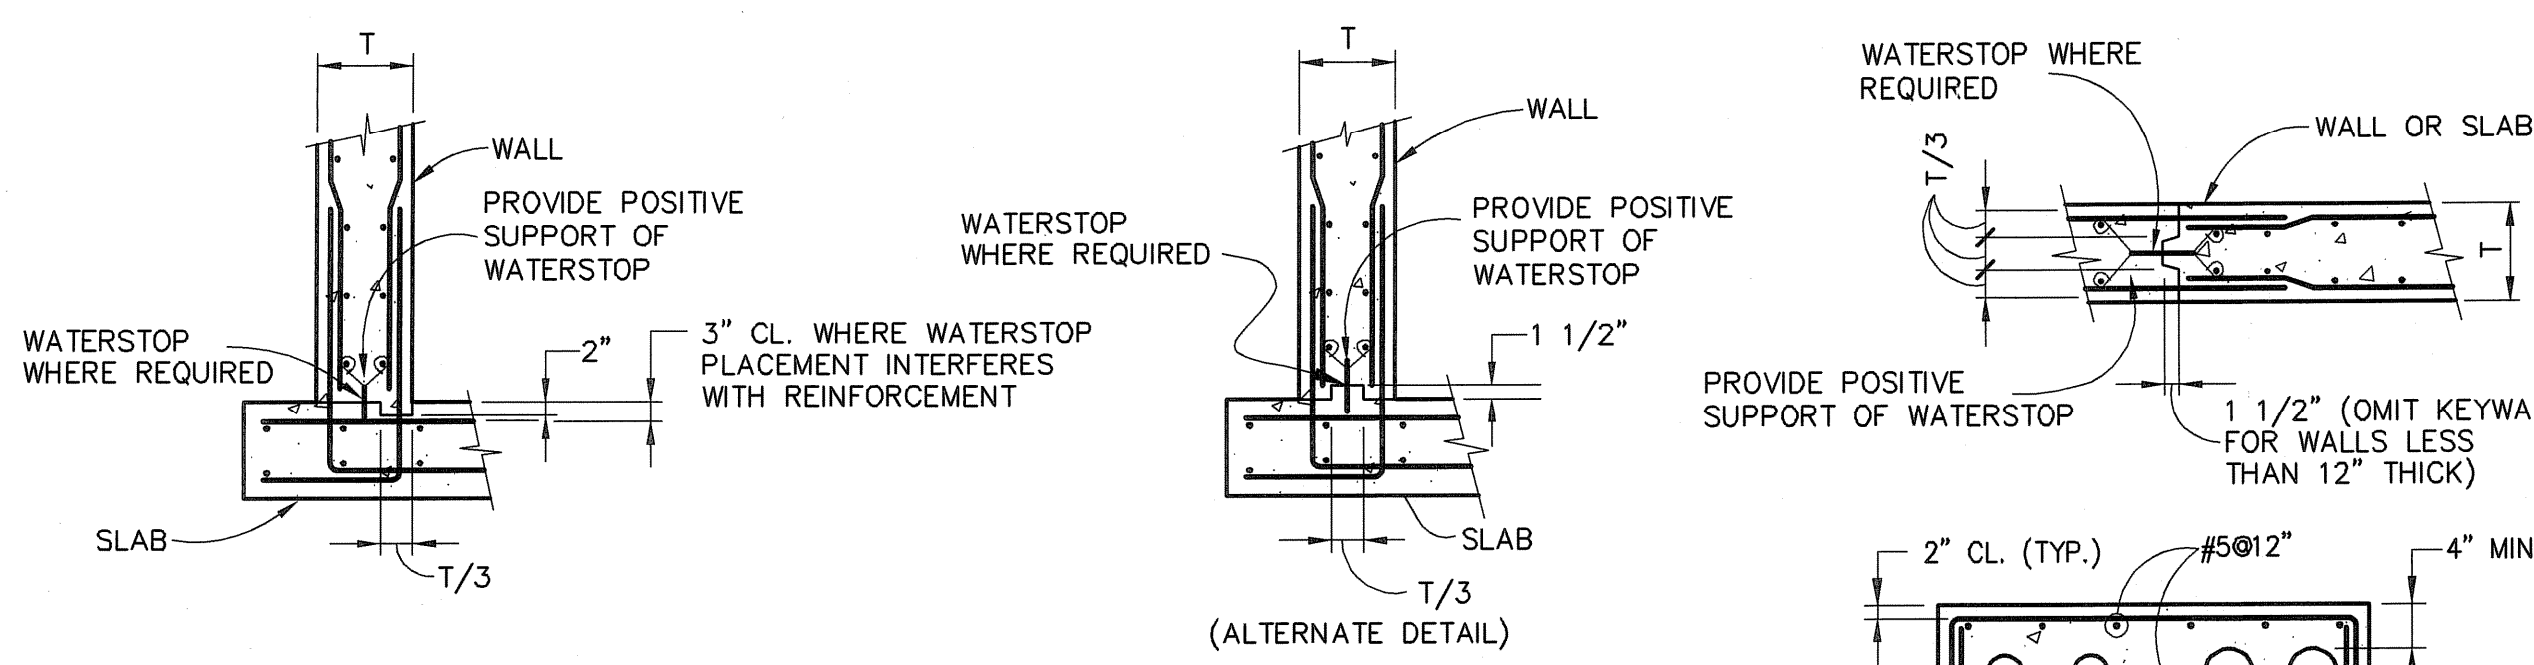


CONSTRUCTION JOINT DETAILS (UNLESS OTHERWISE NOTED)

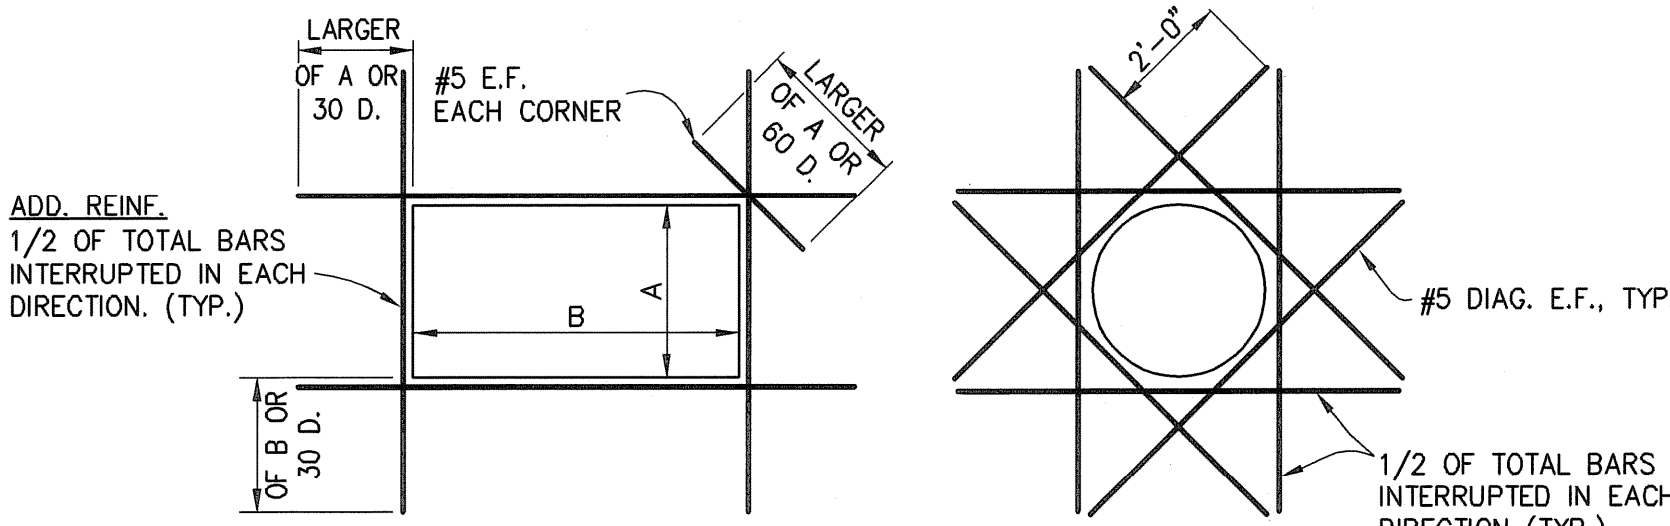

ADDITIONAL REINFORCING AROUND OPENINGS GREATER THAN 1'-0" (UNLESS OTHERWISE NOTED)

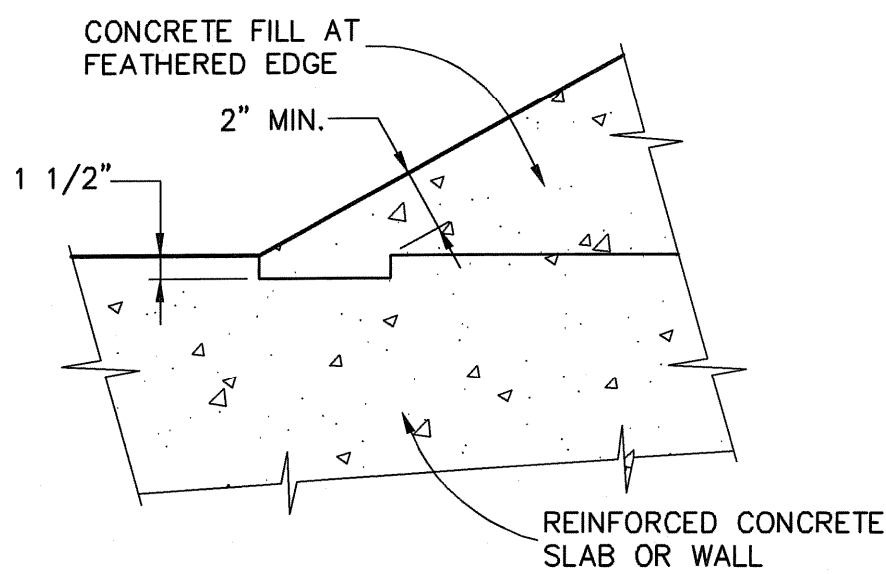


CONCRETE FILL AT SLAB OR WALL DETAIL

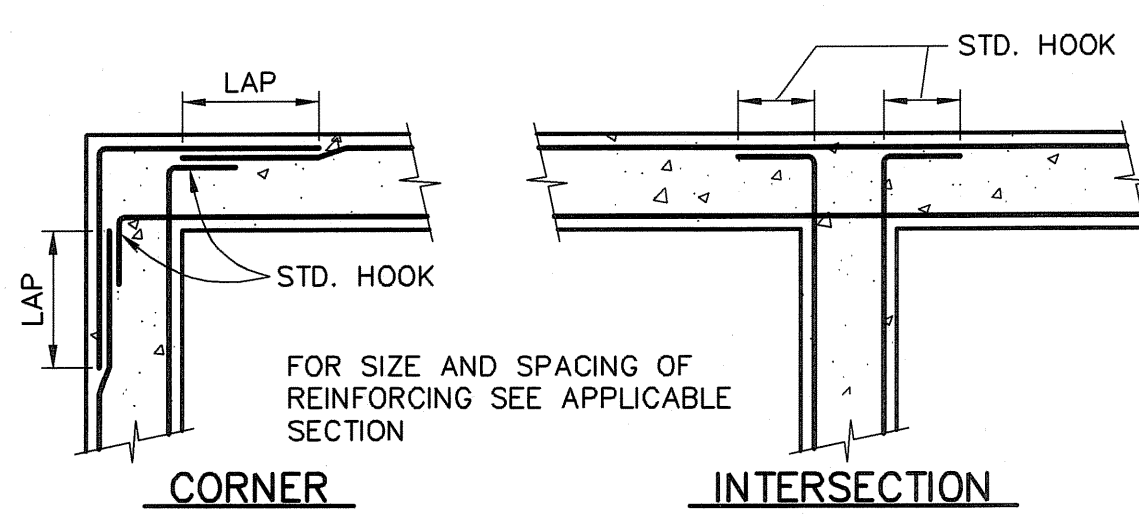


WALL REINFORCING DETAILS (UNLESS OTHERWISE NOTED)


NOTE: VERTICAL REINFORCING NOT SHOWN.

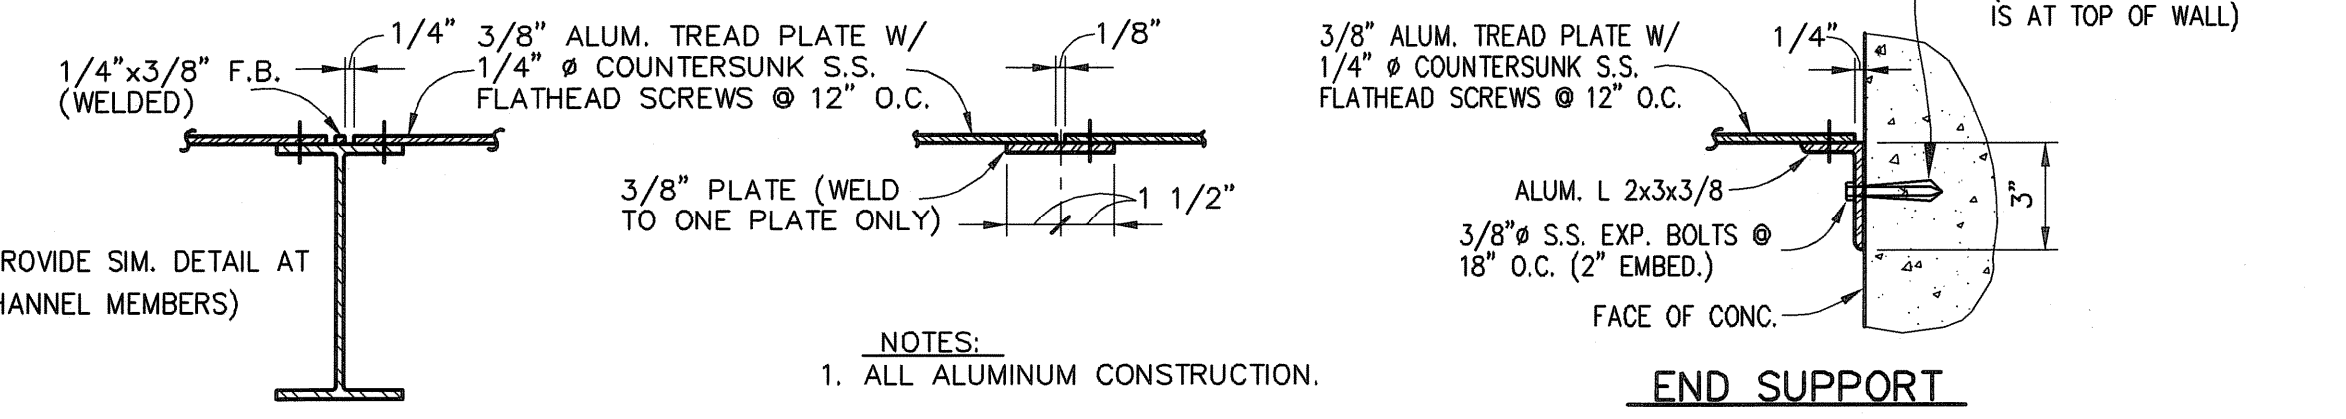


TYPICAL TREAD PLATE SUPPORT DETAILS NOT TO SCALE

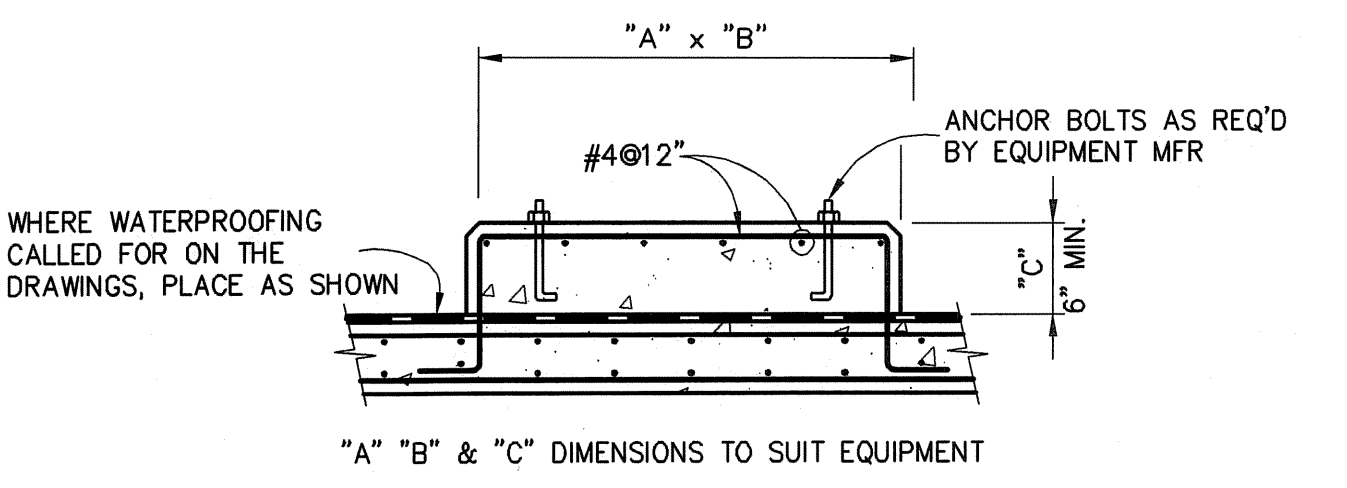


EQUIPMENT PAD DETAIL NOT TO SCALE

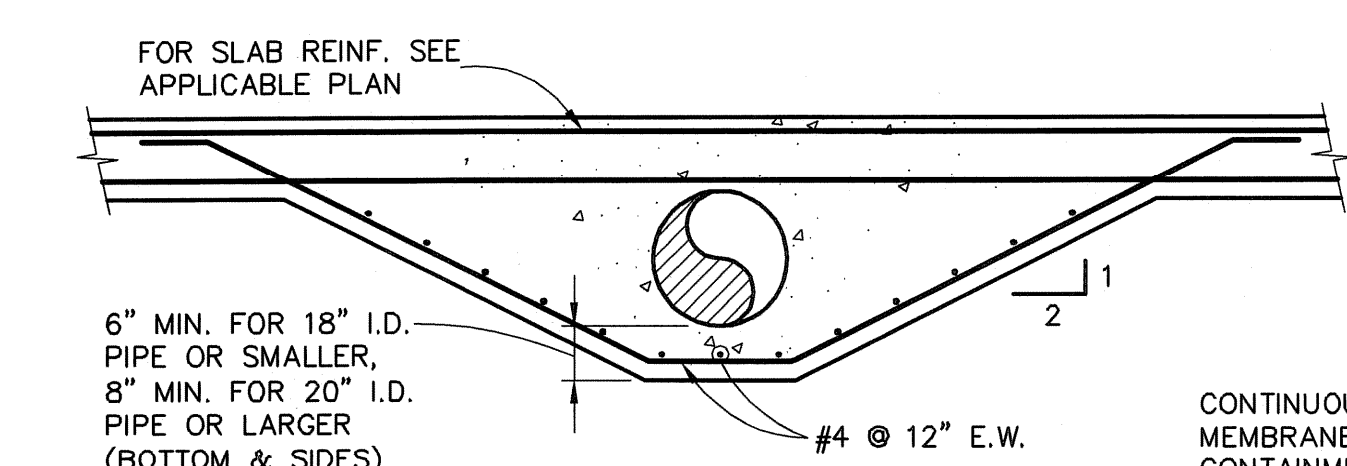


PIPE ENCASEMENT DETAIL NOT TO SCALE

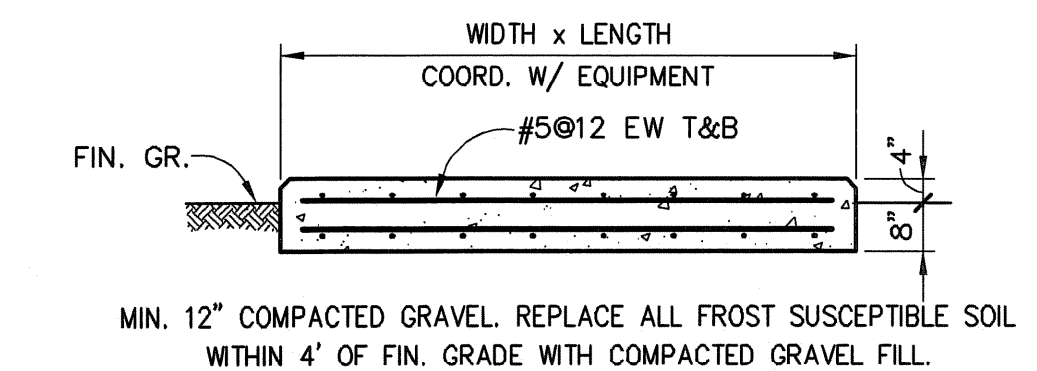


EXTERIOR EQUIPMENT PAD NOT TO SCALE

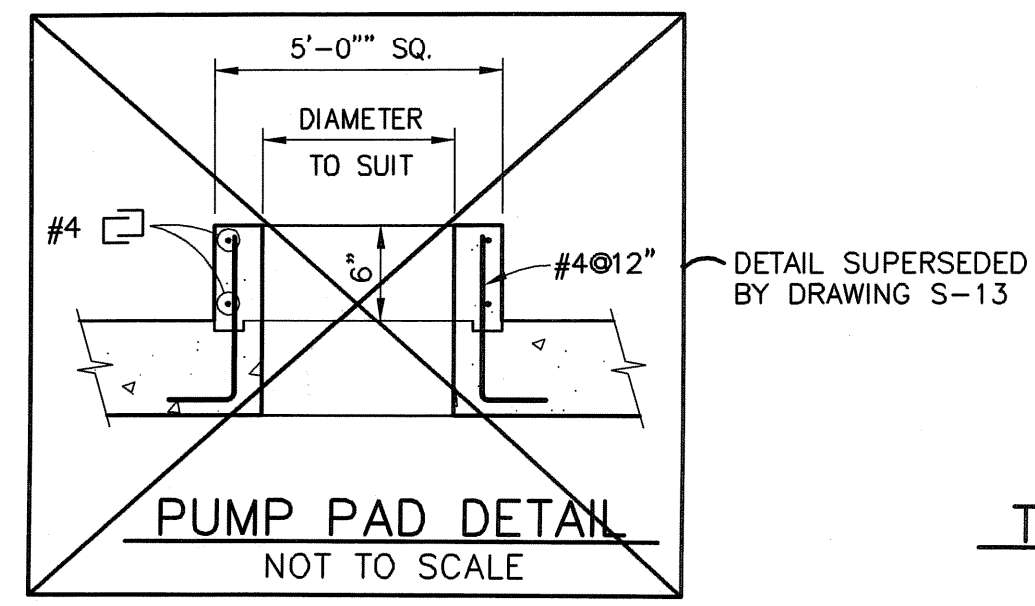


PUMP PAD DETAIL NOT TO SCALE

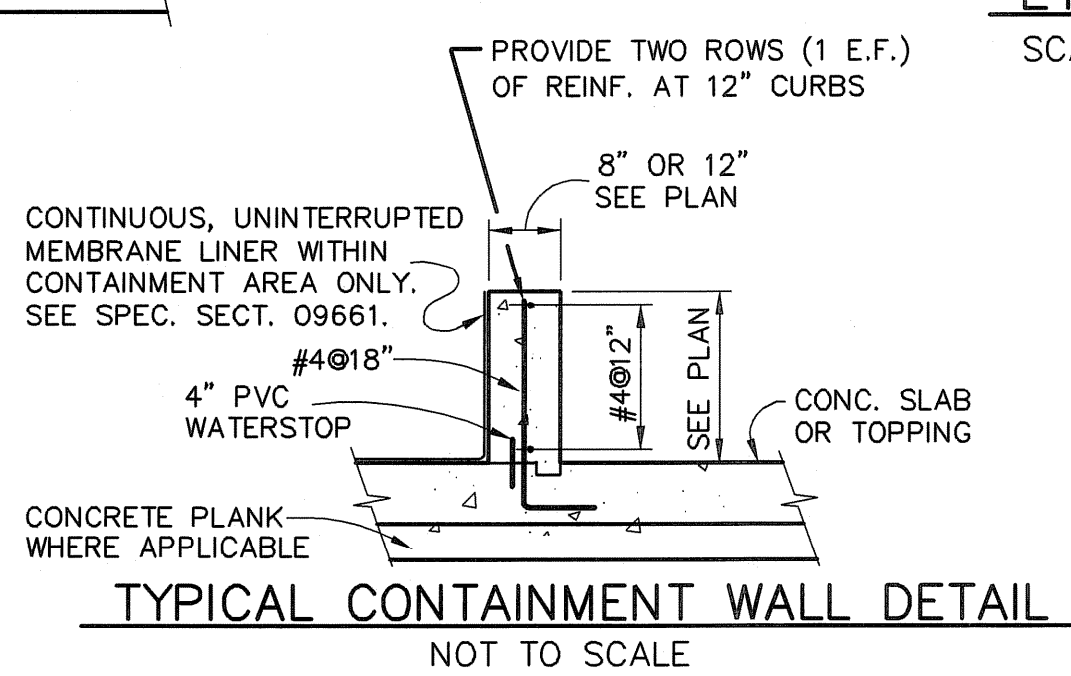


TYPICAL CONTAINMENT WALL DETAIL NOT TO SCALE

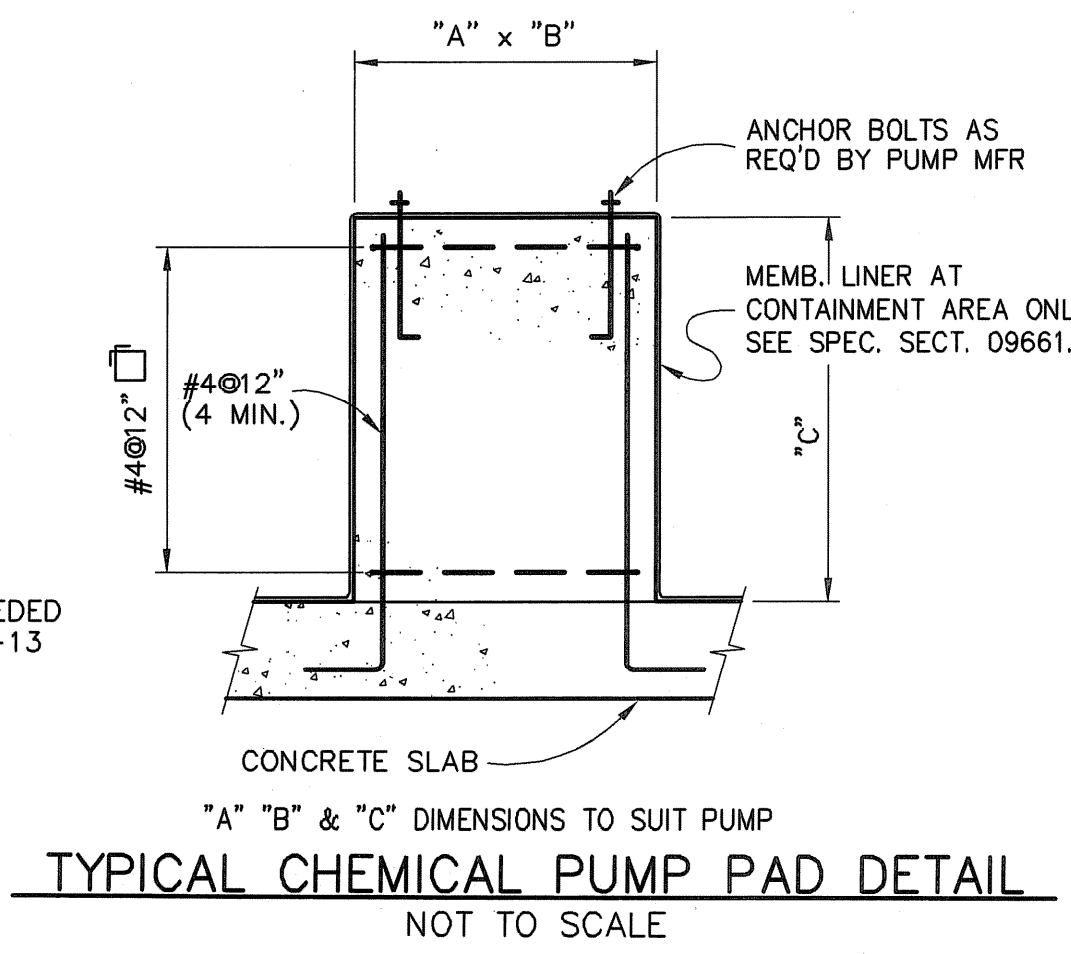


TYPICAL CHEMICAL PUMP PAD DETAIL NOT TO SCALE

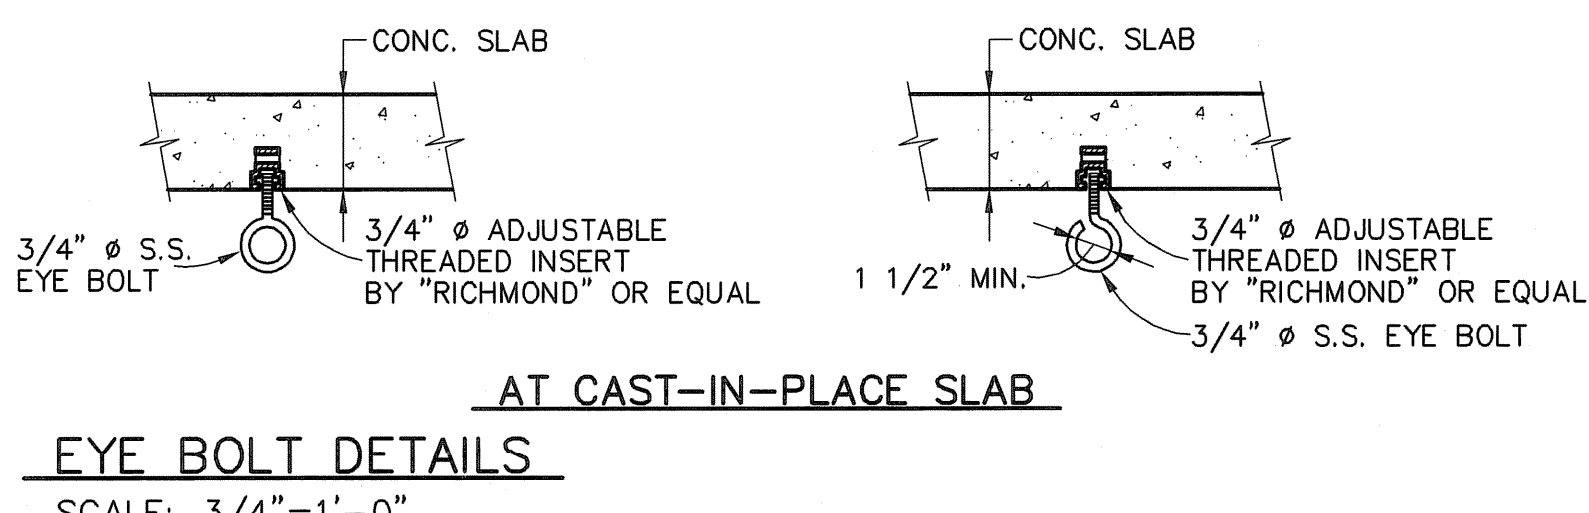


EYE BOLT DETAILS SCALE: 3/4"=1'-0"

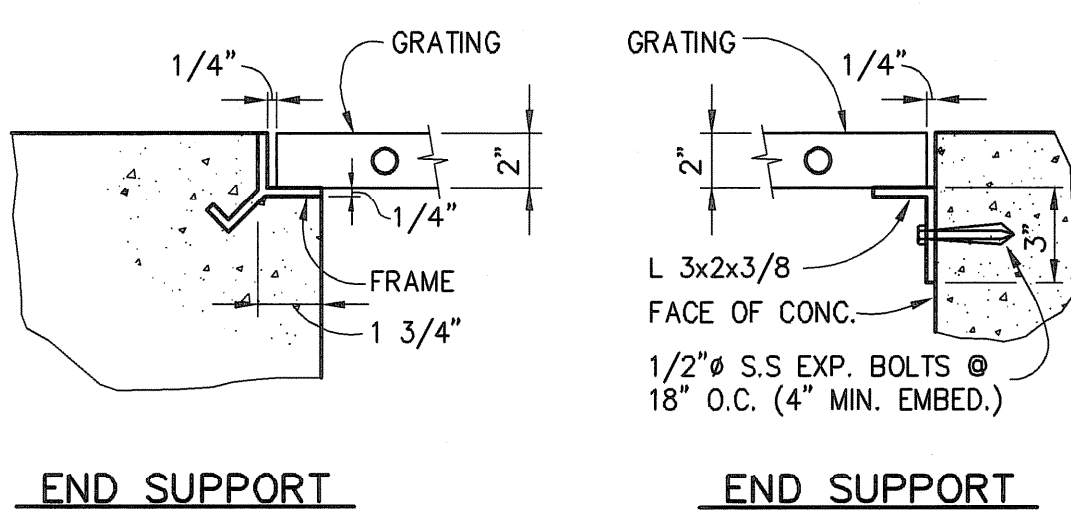





TYPICAL FRP GRATING DETAILS NOT TO SCALE

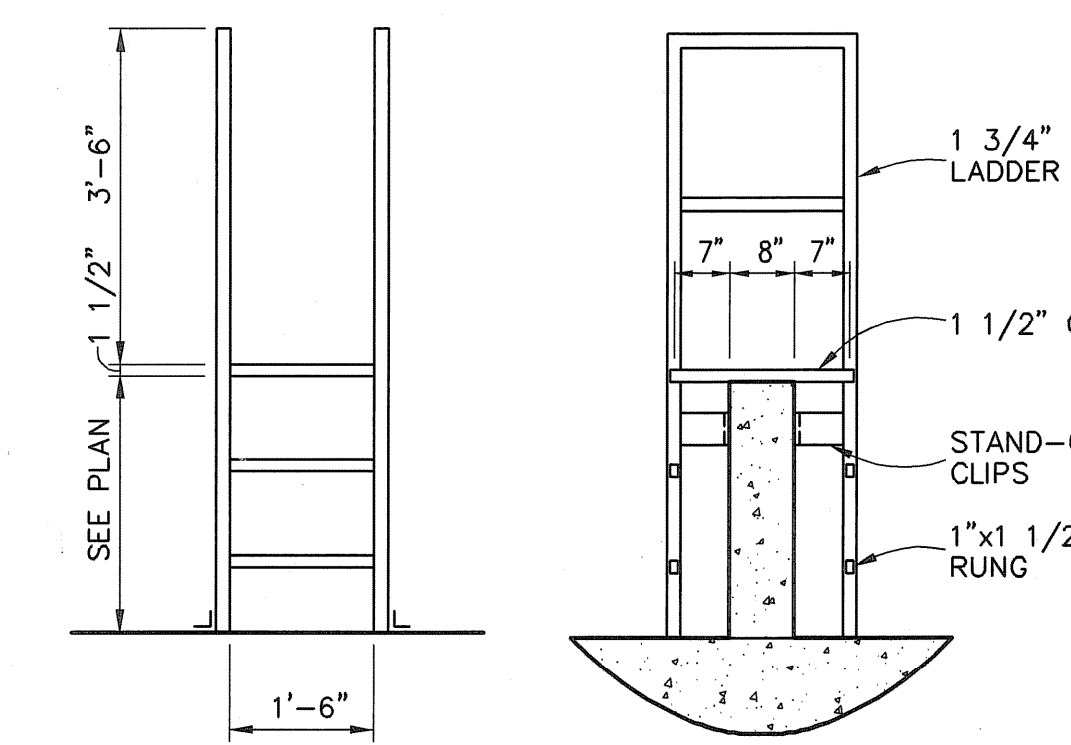


EXTENDED WALKTHRU FRP LADDER SCALE: 1/2"=1'-0"

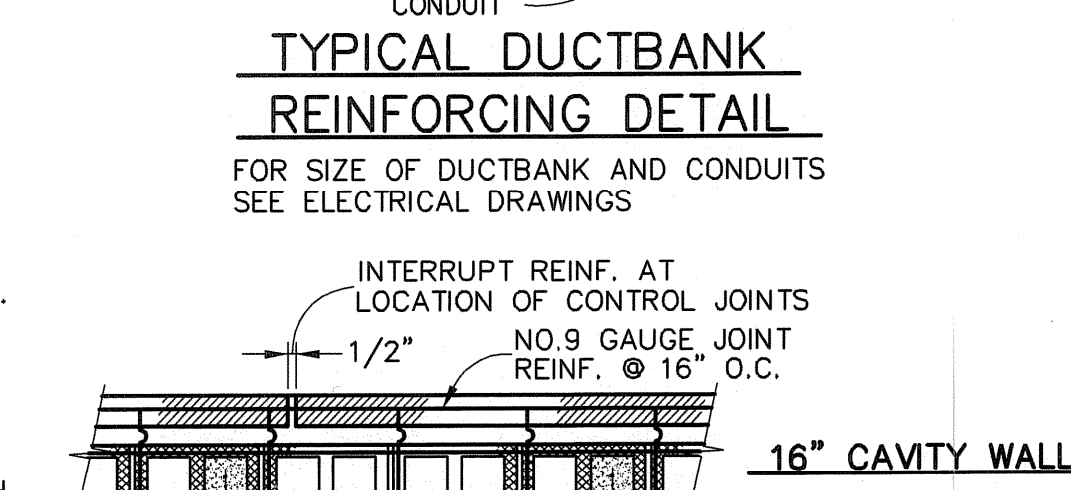

16" CAVITY WALL

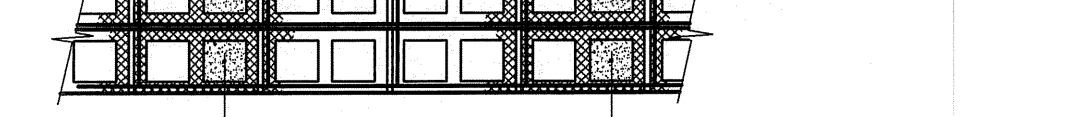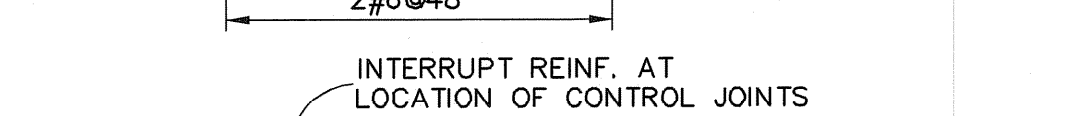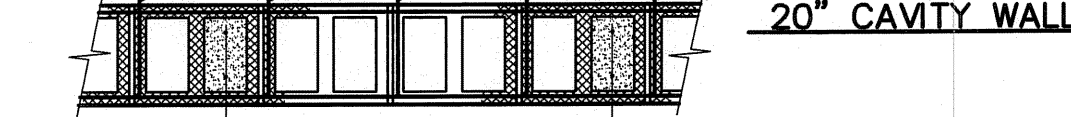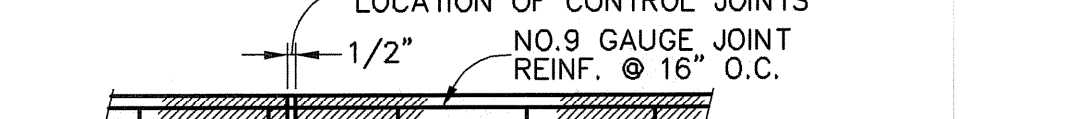

TYPICAL MASONRY REINFORCING DETAILS NOT TO SCALE

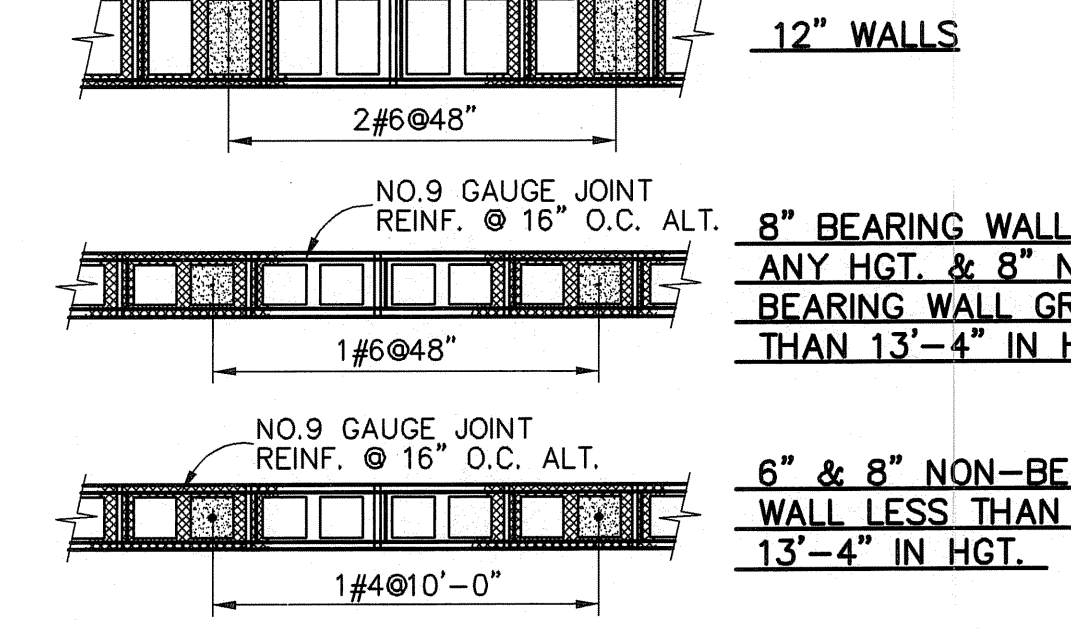

TYPICAL PIPE SUPPORT DETAIL NOT TO SCALE

- NOTES:
- VERTICAL REINFORCING SHALL BE LAID OUT SUCH THAT EACH SIDE OF OPENINGS, CORNERS, INTERSECTIONS AND ENDS OF WALLS ARE REINFORCED.
 - VERTICAL REINFORCING AT SIDE OF OPENINGS SHALL BE CONTINUOUS THROUGH LINTELS.
 - PROVIDE 2-#5 HORZ. BARS AT TOP AND BOTTOM OF OP'NGS (EXTEND 25" PAST FACE OF OP'NG), AND AT KNOCK-OUT BLOCK BOND BEAM AT TOP OF WALL.

STRUCTURAL NOTES

- GENERAL
- THESE NOTES AND TYPICAL DETAILS SHALL APPLY TO ALL STRUCTURES IN THE PROJECT, AS APPLICABLE.
 - STRUCTURAL DRAWINGS SHALL BE USED IN CONJUNCTION WITH ARCHITECTURAL, MECHANICAL, ELECTRICAL, PLUMBING, HEATING AND VENTILATING DRAWINGS AND SPECIFICATIONS. DRAWINGS SHALL BE REFERRED TO FOR SIZE AND LOCATION OF OPENINGS FOR VENTS, PIPES, DUCTS, ETC.
 - ALL DIMENSIONS AND CONDITIONS MUST BE VERIFIED IN THE FIELD AND ANY DISCREPANCIES SHALL BE BROUGHT TO THE ATTENTION OF THE ENGINEER BEFORE PROCEEDING WITH THE AFFECTED PORTION OF WORK.
 - BUILDING CODE: RHODE ISLAND STATE BUILDING CODE (1998) AND AMENDMENTS.
 - DESIGN LIVE LOADS
 ROOF -30 PSF PLUS SNOW DRIFT (SEE DIAGRAMS)
 FLOORS -100 PSF - ROOF OVER PUMP ROOM
 -AS INDICATED ON PLANS

EARTHQUAKE

SEISMIC HAZARD GROUP	II
SEISMIC PERFORMANCE	C
CATEGORY	
SOIL PROFILE TYPE	S1
BASIC STRUCTURAL SYSTEM	LOAD BEARING MASONRY SHEAR WALLS
RESPONSE MODIFICATION FACTOR (R)	3 1/2
DEFLECTION AMPLIFICATION FACTOR (Cd)	3
ANALYSIS PROCEDURE	EQUIVALENT LATERAL FORCE

- FOUNDATIONS
- NO BACKFILL SHALL BE PLACED AGAINST FOUNDATION WALLS WHICH HAVE NOT BEEN CURED FOR AT LEAST 7 DAYS.
 - BACKFILL SHALL NOT BE PLACED AGAINST FOUNDATION WALLS UNTIL SUPPORTING FRAMED SLABS HAVE BEEN PLACED AND THE FORMS REMOVED. BACKFILL SHALL BE PLACED AND COMPACTED ON ALL SIDES OF STRUCTURE SIMULTANEOUSLY.
 - NO FOOTINGS SHALL BE PLACED ON LOOSE OR DISTURBED SOILS, IN WATER NOR ON FROZEN GROUND.
 - A MINIMUM OF 12 INCHES OF CRUSHED STONE SHALL BE PLACED BENEATH THE MAT FOR THE 5 MG WATER STORAGE TANK AND THE WETWELL IN THE FILTRATION BUILDING. A MINIMUM OF 12 INCHES OF COMPACTED GRAVEL SHALL BE PLACED BENEATH ALL OTHER FOUNDATION MATS, FOOTINGS, AND SLAB-ON-GRADE.
 - COMPACT ALL FILL UNDER THE SLAB-ON-GRADE AND ANY OTHER AREAS NOTED TO AT LEAST 95% OF MAXIMUM DENSITY AS SPECIFIED. VERIFY FIELD DENSITY AS SPECIFIED.
 - STRUCTURES MUST BE PROTECTED AGAINST BUOYANCY AT ALL TIMES DURING CONSTRUCTION.

- CONCRETE
- ALL CONCRETE SHALL HAVE A MINIMUM 28-DAY COMPRESSIVE STRENGTH OF 4500 PSI, UNLESS OTHERWISE NOTED.
 - REINFORCING STEEL SHALL COMPLY WITH THE FOLLOWING:
 - ASTM DESIGNATION A615 GRADE 60.
 - REINFORCEMENT SHALL COMPLY WITH THE TABLE, "CONCRETE PROTECTION FOR REINFORCEMENT", UNLESS OTHERWISE NOTED.
 - FOR MINIMUM BAR SPLICE LENGTHS SEE TABLE SHOWN ON THIS DRAWING.
 - WELDED WIRE FABRIC SHALL CONFORM TO ASTM A-185.
 - CONTRACTOR SHALL COORDINATE LOCATIONS OF FLOOR DRAINS, PIPING, ELECTRICAL CONDUITS, GROUNDS, SLEEVES, INSERTS, ETC. WITH CONCRETE CONSTRUCTION.
 - CONSTRUCTION JOINTS IN WALLS AND SLABS SHALL BE KEED. USE OF CONSTRUCTION JOINTS OTHER THAN THOSE SHOWN ON THE DRAWINGS WILL REQUIRE APPROVAL OF THE ENGINEERS.
 - WATERSTOPS ARE NOT NECESSARILY SHOWN AT EVERY JOINT; BUT WHERE THEY ARE SHOWN, IT IS INTENDED THAT THEY BE COMPLETE AND CONTINUOUS THROUGHOUT THAT PARTICULAR STRUCTURE. WATERSTOPS IN VERTICAL JOINTS SHALL EXTEND TO THE ELEVATION OF FINISH GROUND GRADE, EXCEPT FOR TANKS THEY SHALL EXTEND FULL HEIGHT.
 - PROVIDE WALL SLEEVES WITH INTERMEDIATE WALL COLLARS AT ALL CAST/DUCTILE IRON AND PLASTIC PIPE PENETRATIONS, UNLESS OTHERWISE INDICATED.
 - PROVIDE ALL NECESSARY CHAIRS, CHAIR BARS, SPACERS ETC. WIRE SECURELY TO HOLD REINFORCING IN POSITION. THESE ACCESSORIES SHALL BE PLASTIC BOOTED WHERE CONCRETE IS TO BE EXPOSED TO WEATHER OR MOISTURE.
 - BEAMS AND COLUMNS SHALL NOT BE PENETRATED UNLESS SPECIFICALLY SHOWN ON STRUCTURAL DRAWINGS OR APPROVED BY THE ENGINEER.
 - ALL EXPOSED CORNERS OF CONCRETE BEAMS AND WALLS SHALL HAVE A 3/4" CHAMFER UNLESS OTHERWISE NOTED.

EARTH TECH AS-BUILT FILE JULY 2008

EarthTech
 A Tyco International Ltd. Company
 300 BAKER AVENUE SUITE 290 CONCORD MA 01742 (978) 371-4000


PAWTUCKET, RHODE ISLAND
 PAWTUCKET REGIONAL WATER TREATMENT FACILITY
 PKG 9 - UPPER CONCRETE
 STRUCTURAL DETAILS AND NOTES

DESIGNED BY: DWG SCALE AS NOTED
 DRAWN BY: DPB CONTRACT NO.
 CHECKED BY: DATE OCTOBER 31, 2008


S-9
 SHEET OF

Filename: L:\WORK\69993\CAD\AS-BUILT\9) WTP\STRUC\69993S-9.DWG
 Plot File Date: Aug 11, 2008 4:07 PM


Filename: L:\WORK\69993\CAD\AS-BUILT\9) WTP\STRUC\69993S-10.DWG
 Plot File Date Created: Aug/11/2008 4:38 PM

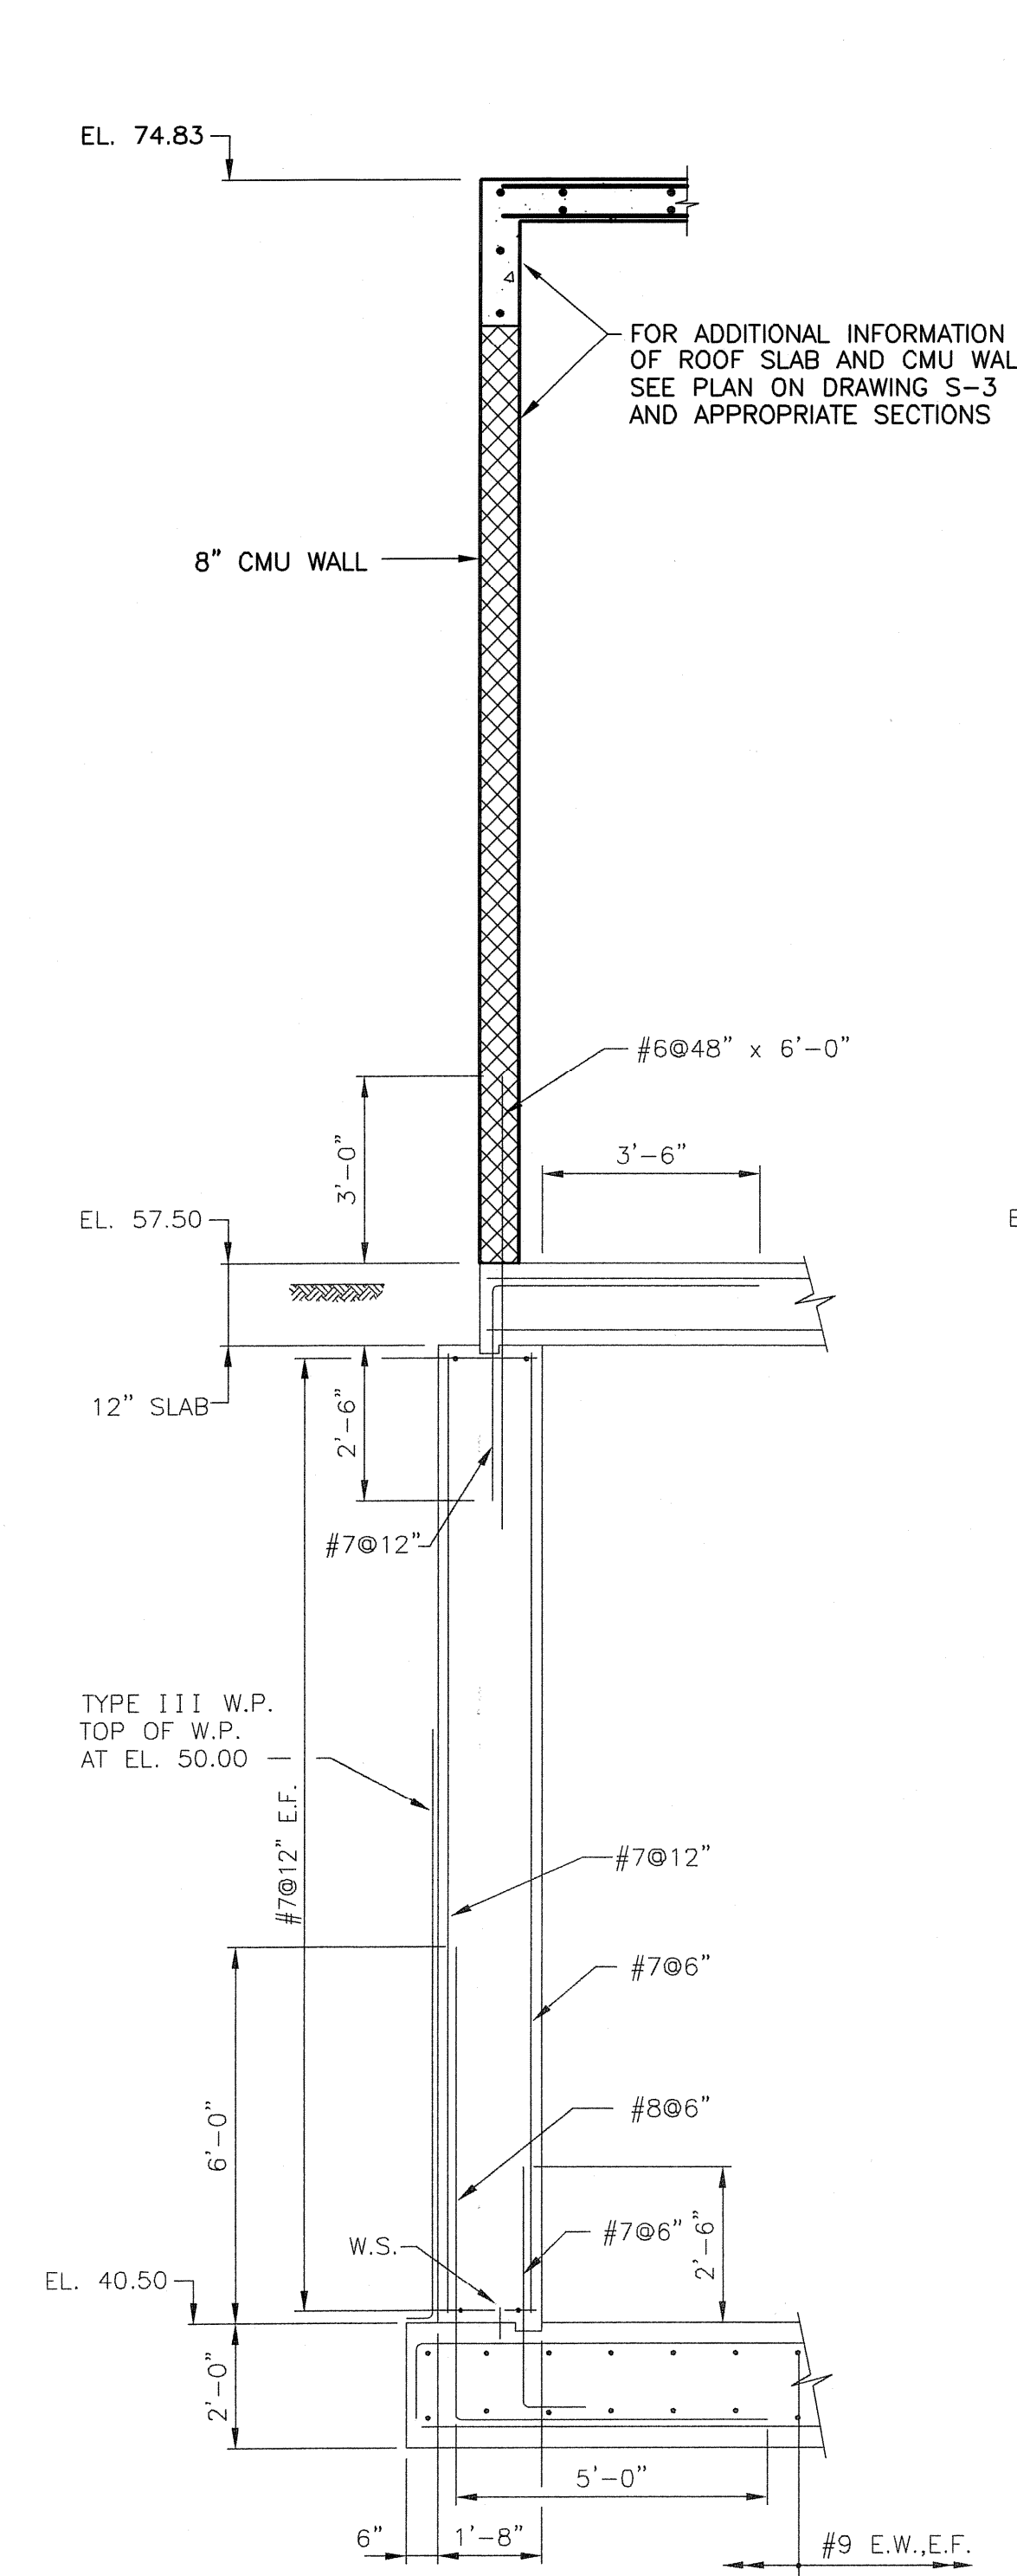


SECTION 19
 S-1
 SCALE: 3/8" = 1'-0"

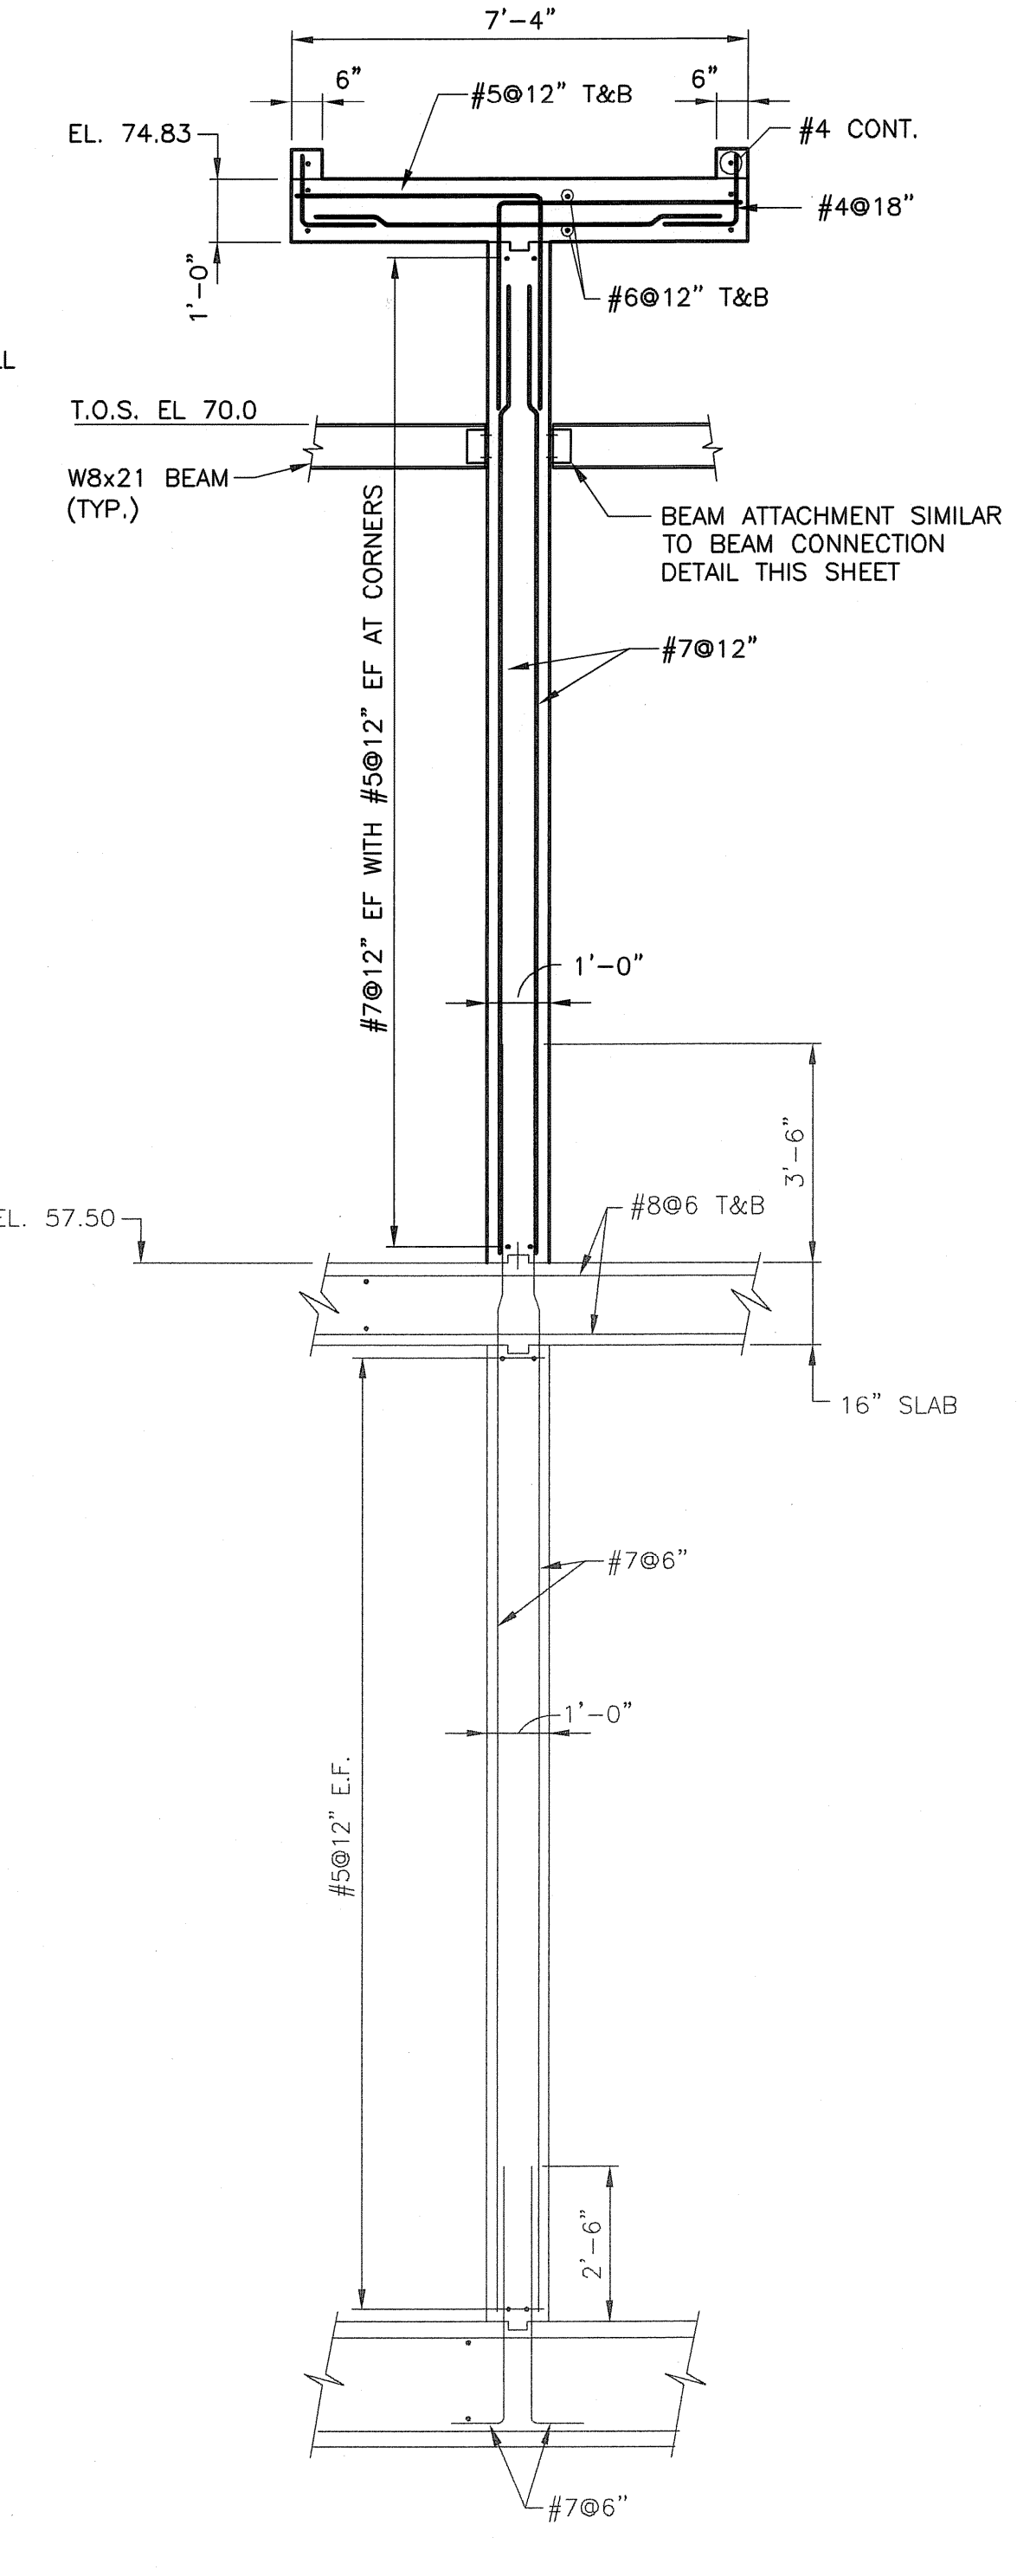


SECTION 20
 S-1
 SCALE: 3/8" = 1'-0"

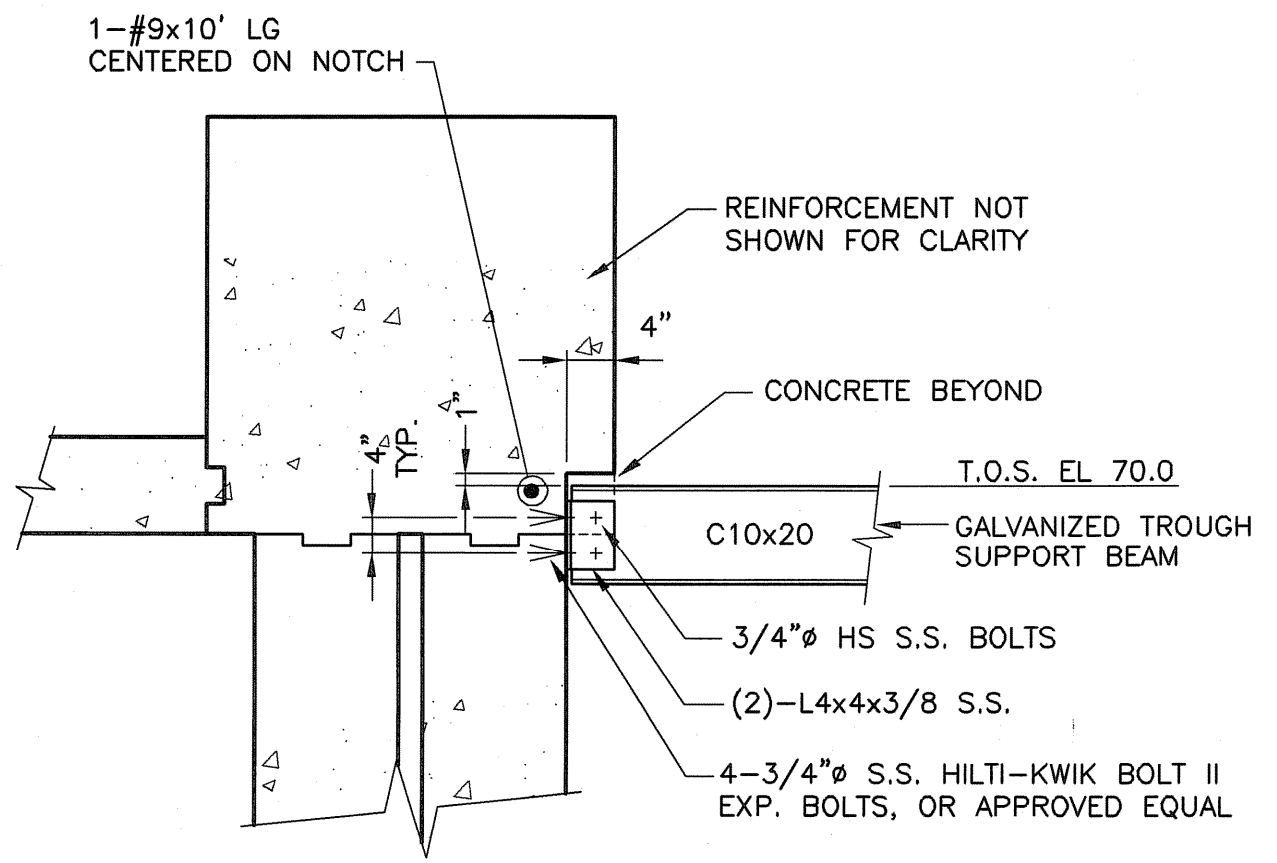


BEAM CONNECTION DETAIL
 SCALE: 3/4" = 1'-0"

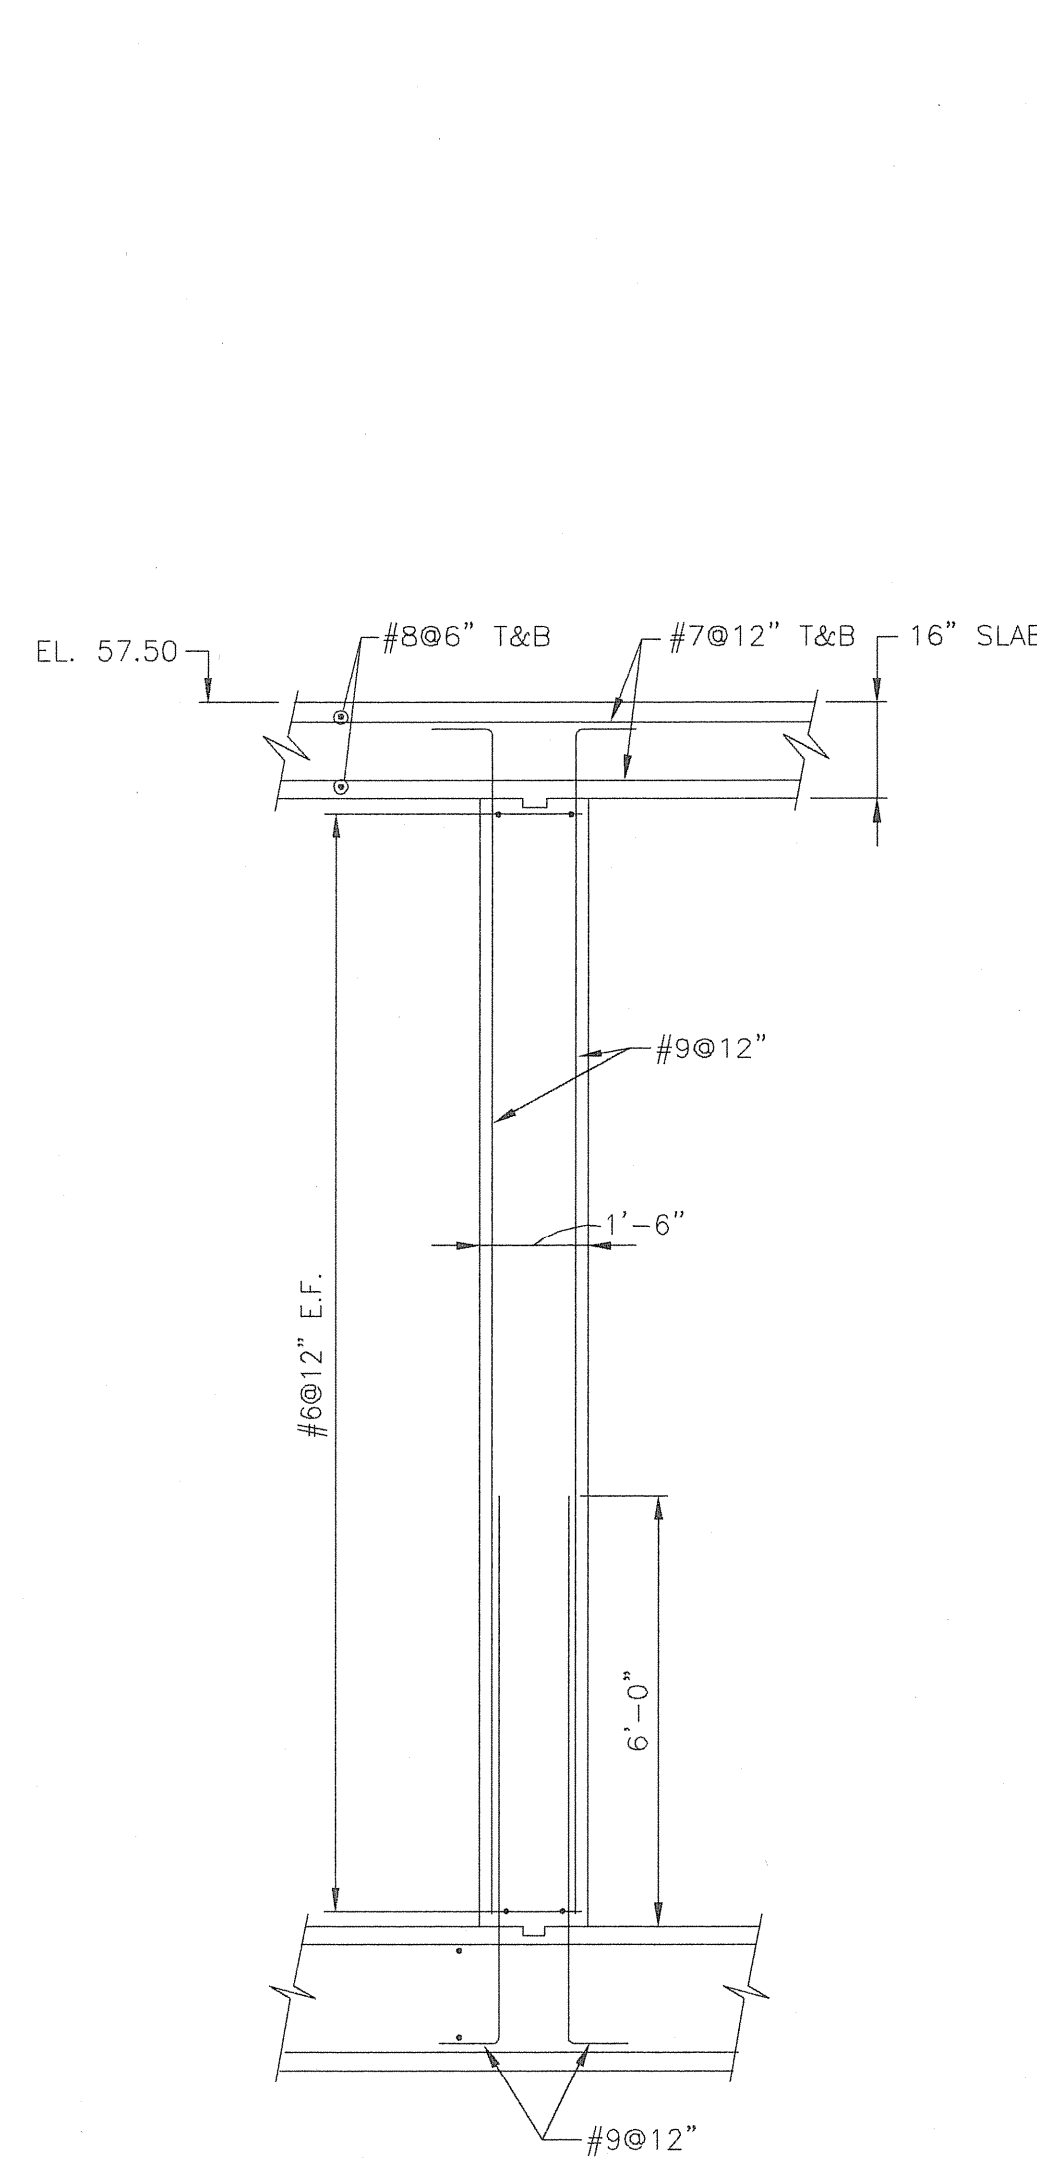


SECTION 21
 S-1
 SCALE: 3/8" = 1'-0"

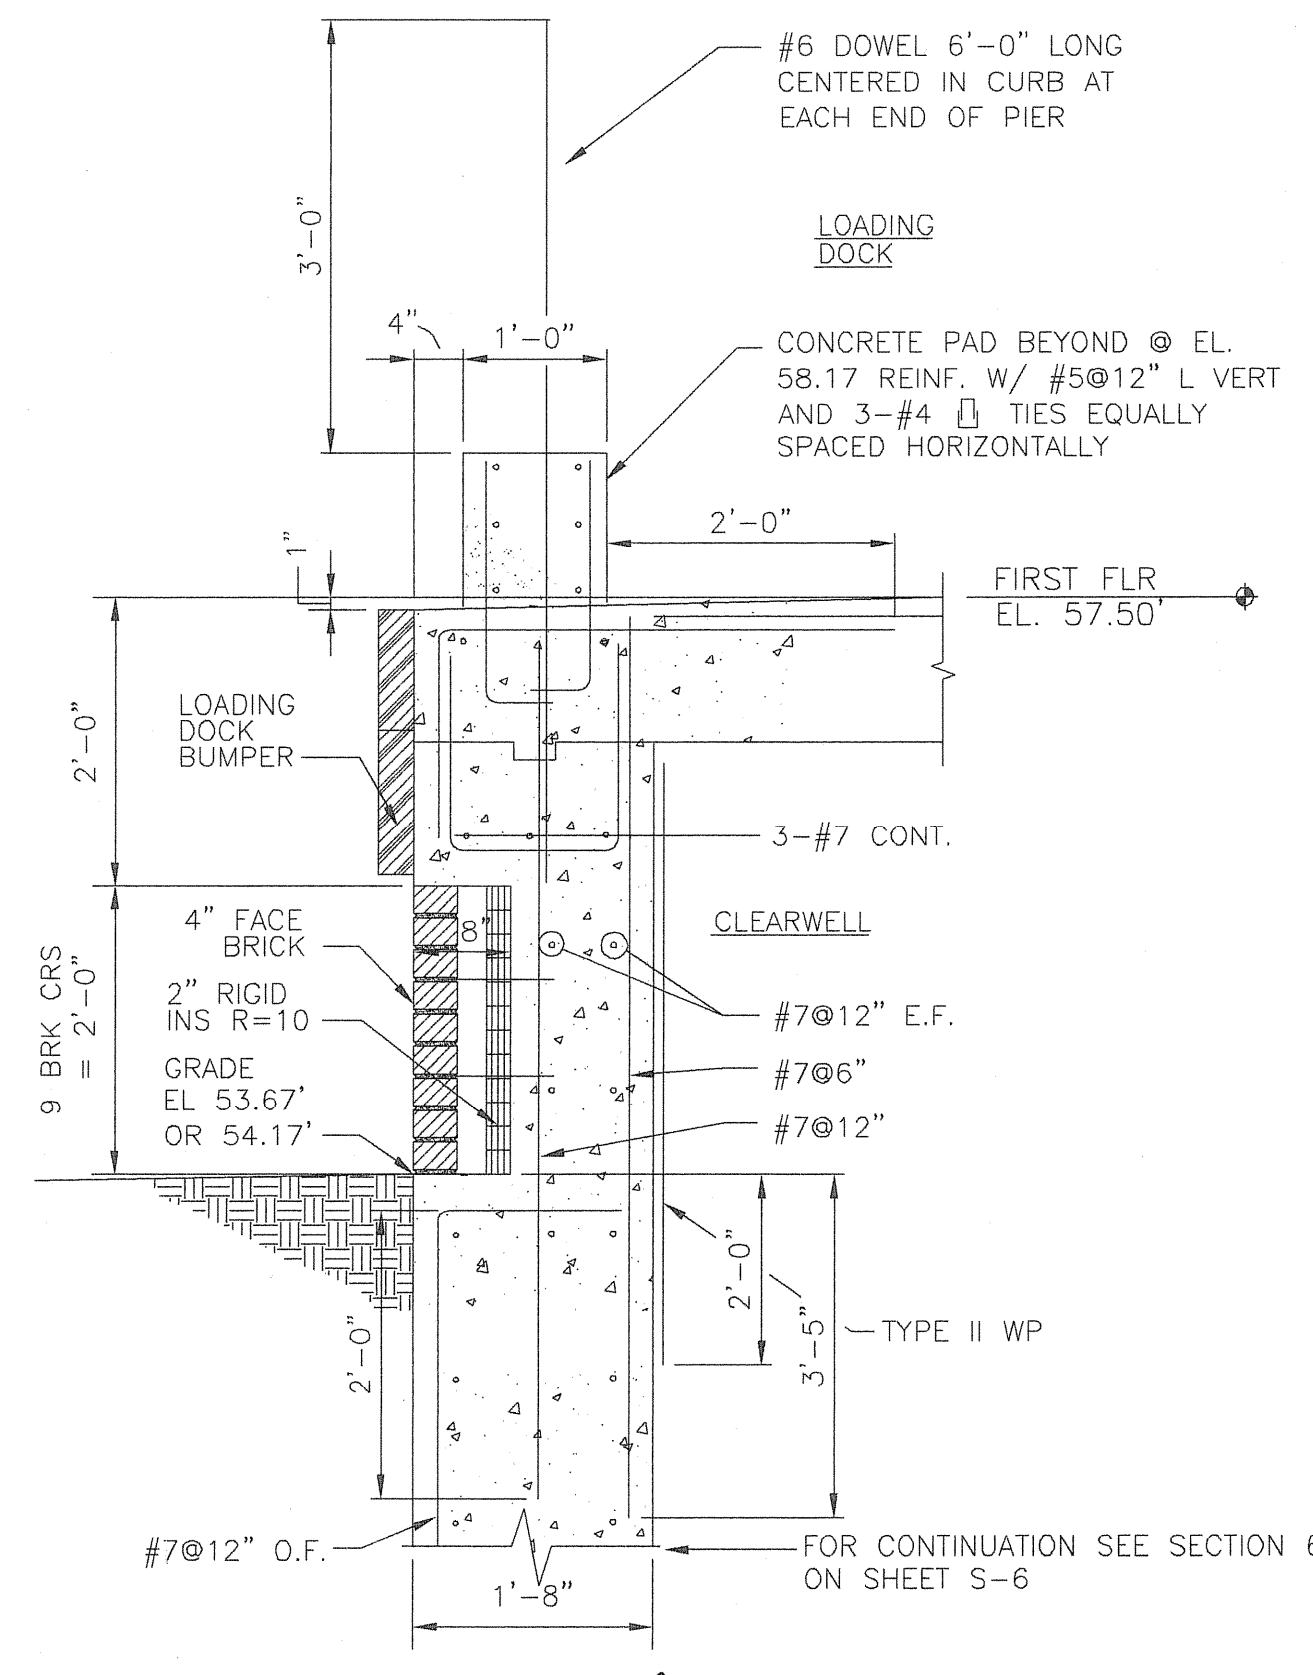


SECTION 26
 S-2
 SCALE: 3/4" = 1'-0"

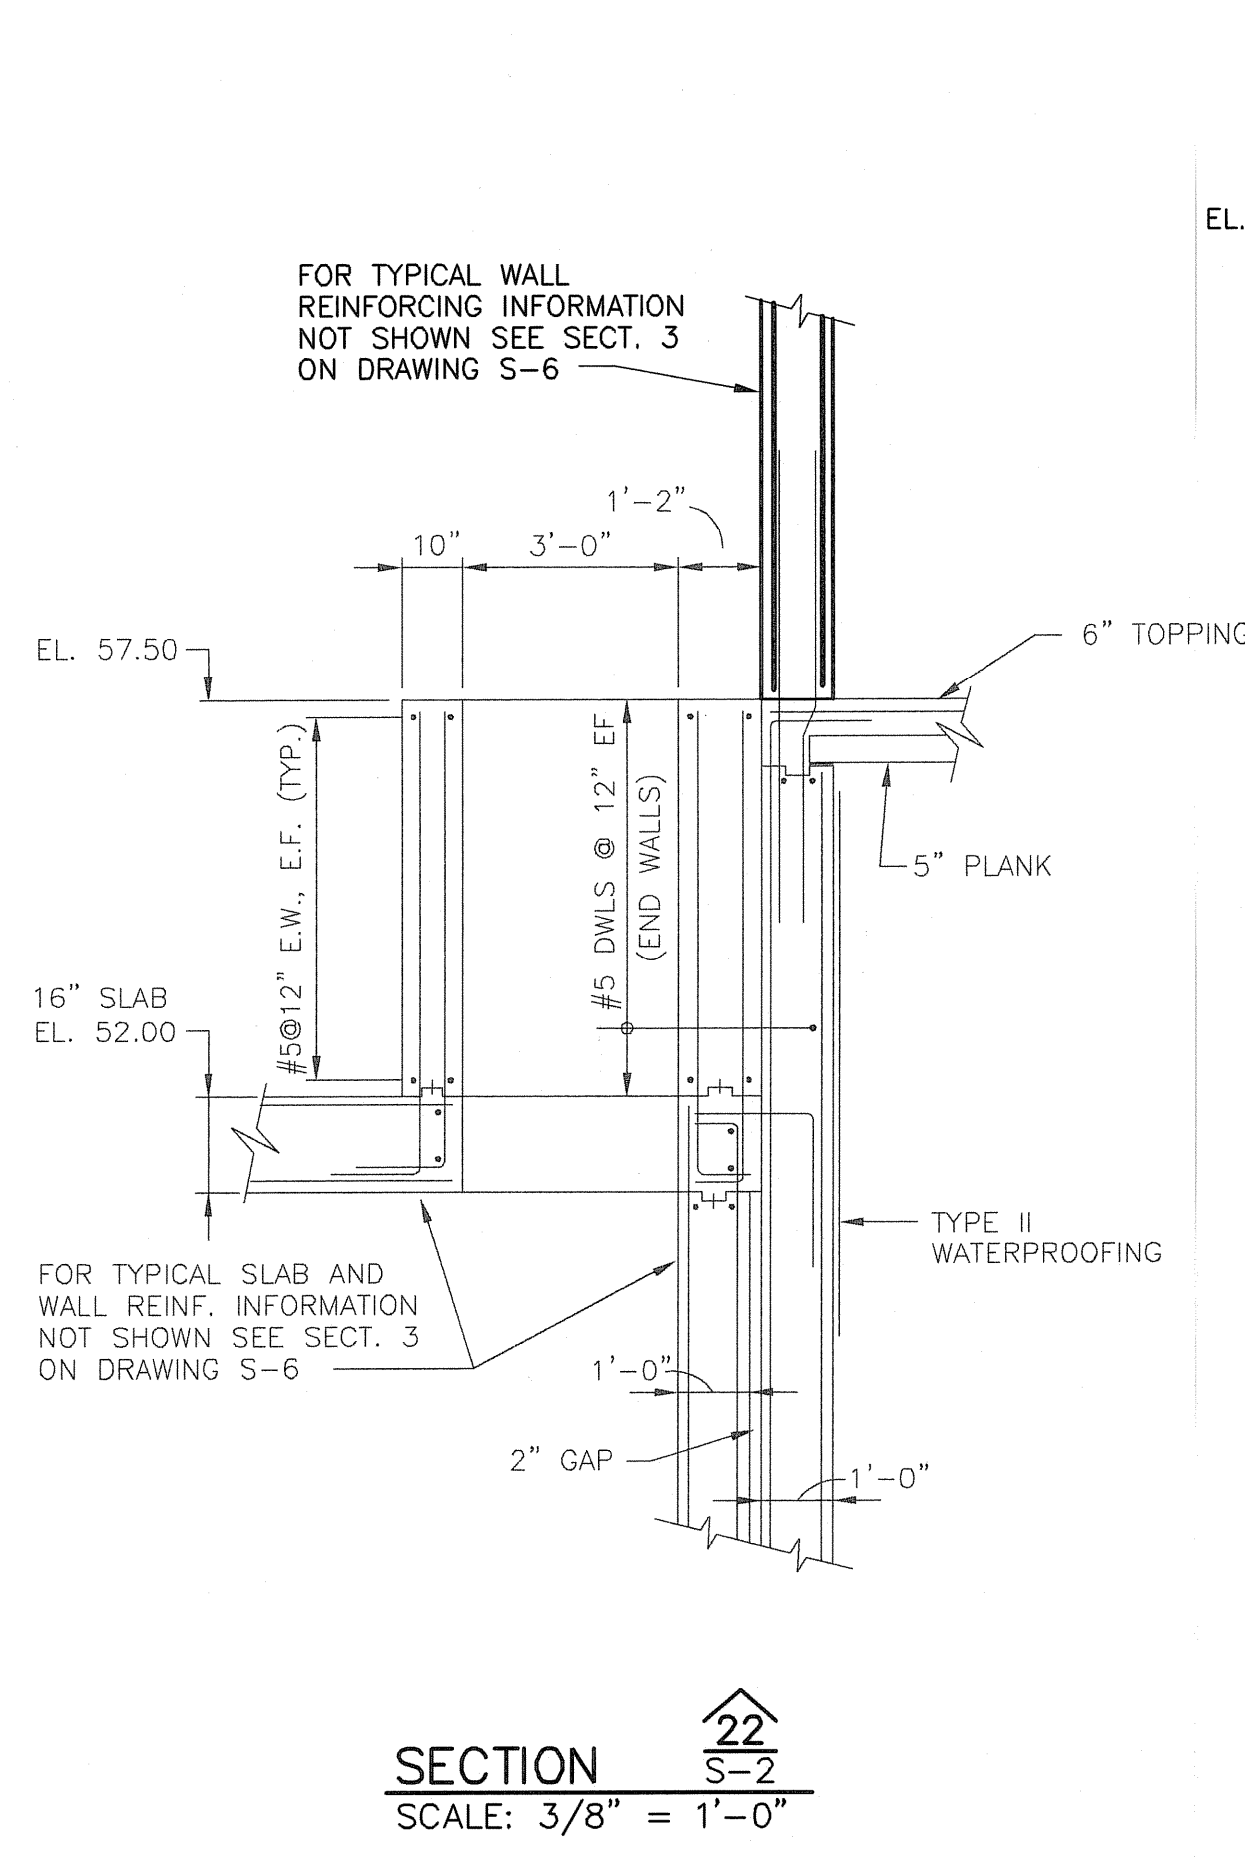


SECTION 22
 S-2
 SCALE: 3/8" = 1'-0"

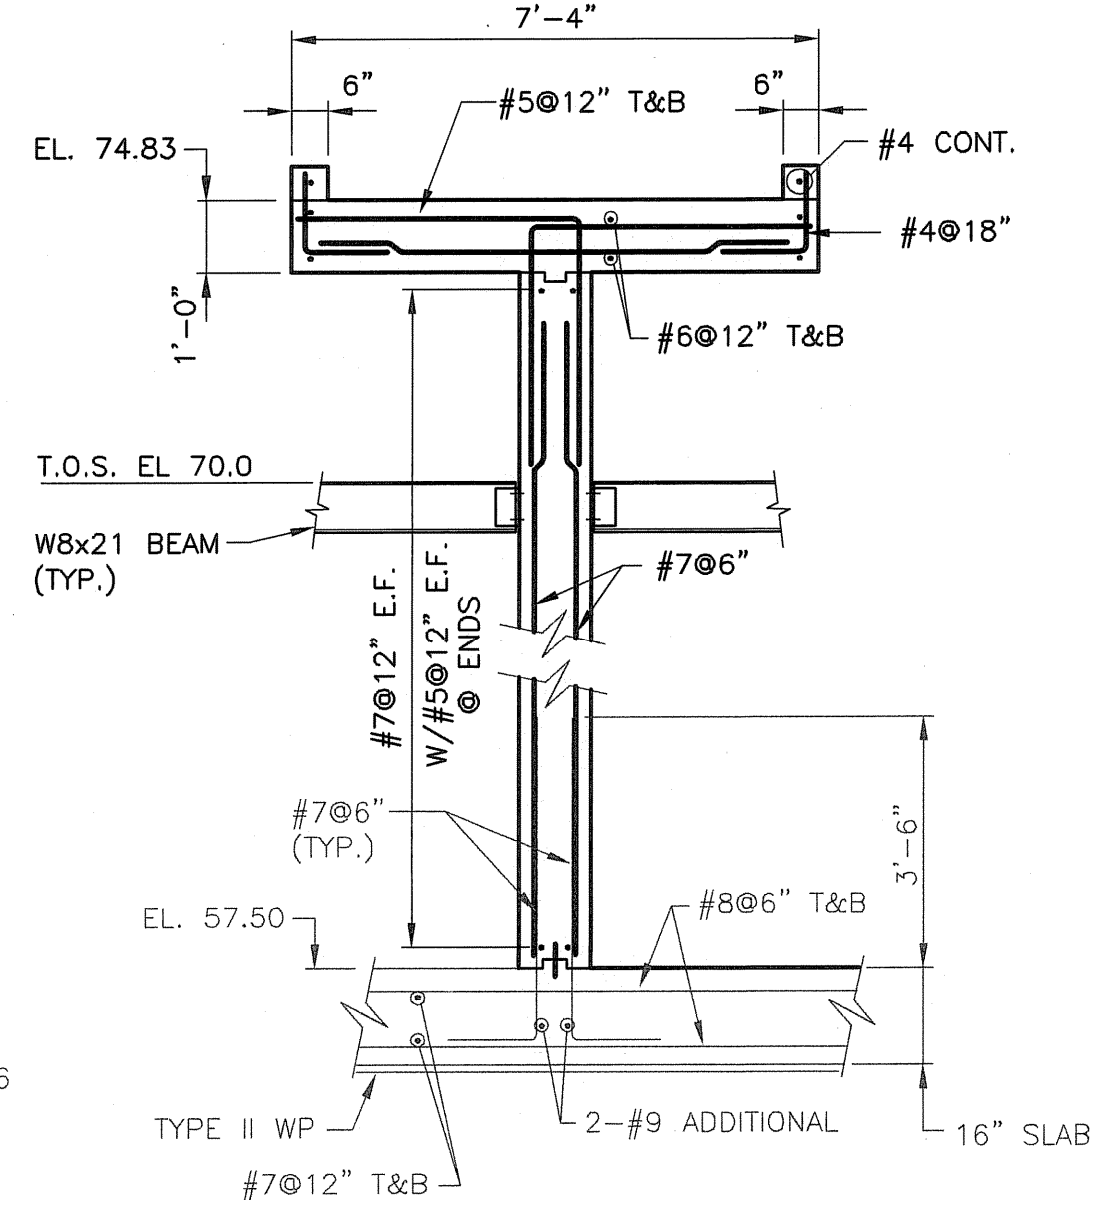

SECTION 25
 S-2
 SCALE: 3/8" = 1'-0"

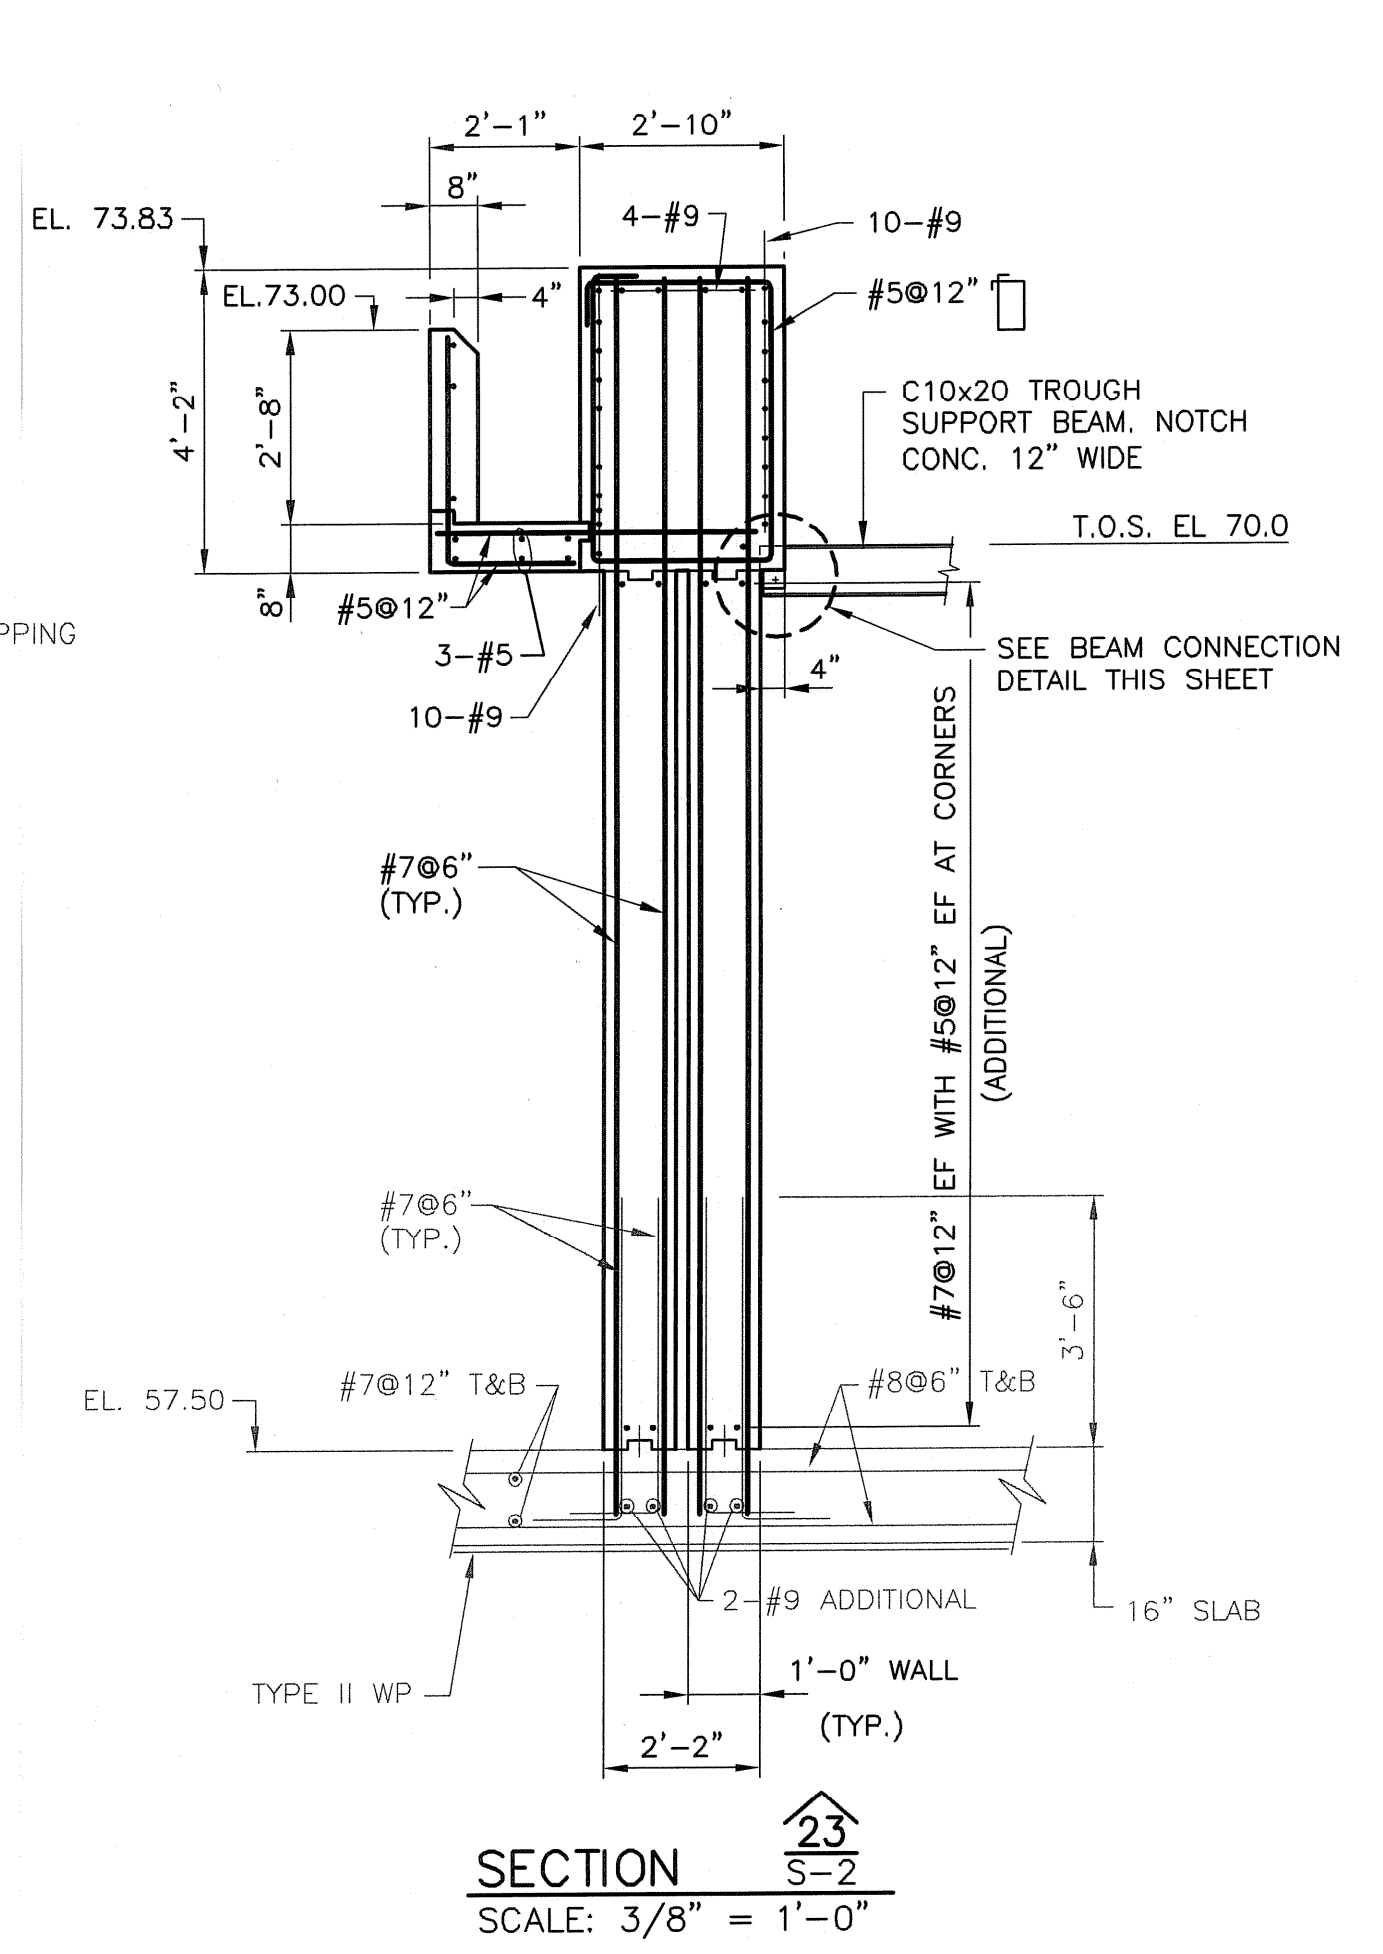


SECTION 23
 S-2
 SCALE: 3/8" = 1'-0"

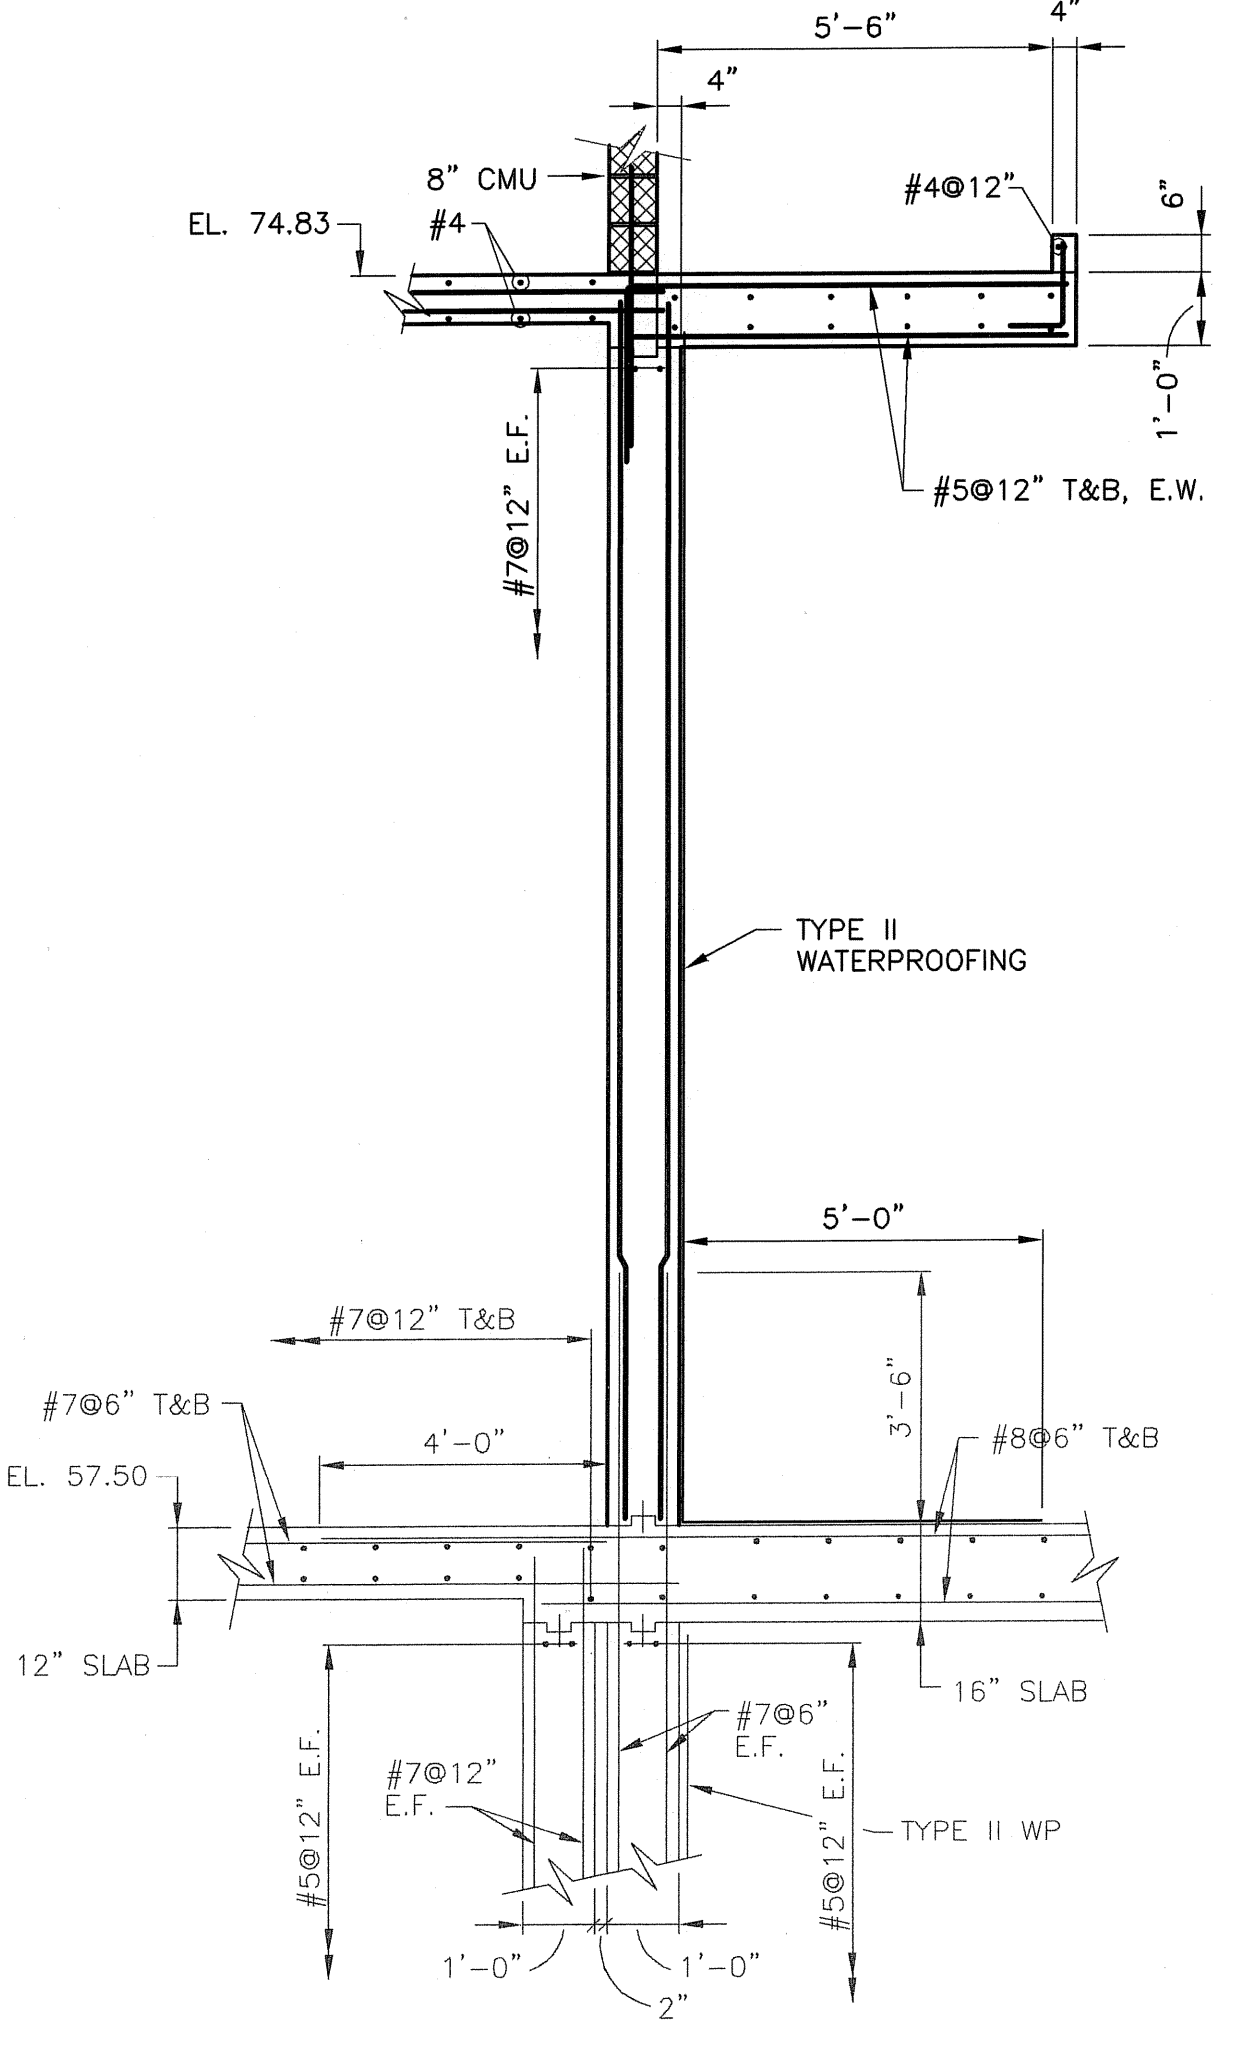

SECTION 24
 S-2
 SCALE: 3/8" = 1'-0"

NOTE:
 FOR MAIN ENTRANCE AND LOADING DOCK
 STAIR SECTIONS SEE DRAWING S-10 ON
 PACKAGE 3.

NO.	REVISIONS	BY	DATE
2	AS-BUILT DRAWING FILE	DPB	JULY 2008

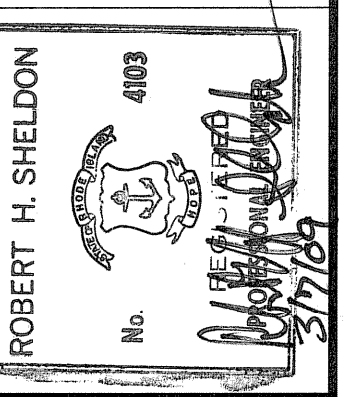






PAWTUCKET, RHODE ISLAND
**PAWTUCKET REGIONAL
 WATER TREATMENT FACILITY**
PKG 9 - UPPER CONCRETE
 SECTIONS AND DETAILS

DESIGNED BY	DWG SCALE
DRAWN BY	CONTRACT NO.
CHECKED BY	DATE

EARTH TECH
 AS-BUILT FILE
 JULY 2008


S-10
 SHEET OF

Filename: L:\WORK\69993\CAD\AS-BUILT\9) WTP\STRUC\69993S3-5-11-12.DWG
 Plot File Date Created: Aug/11/2008 4:02 PM

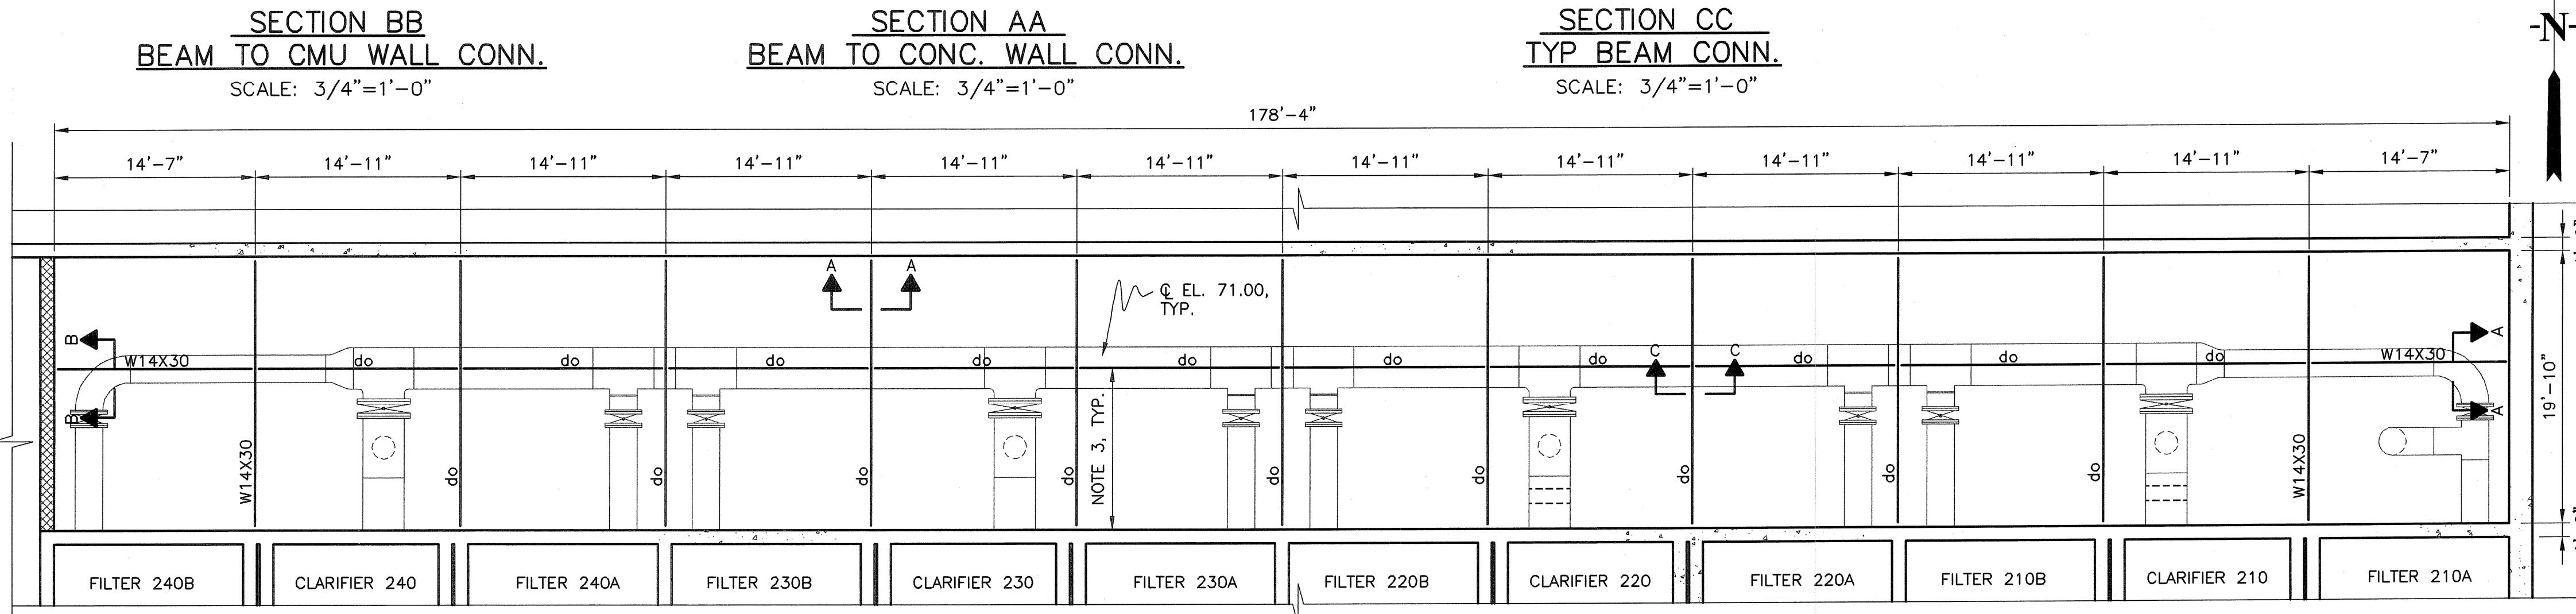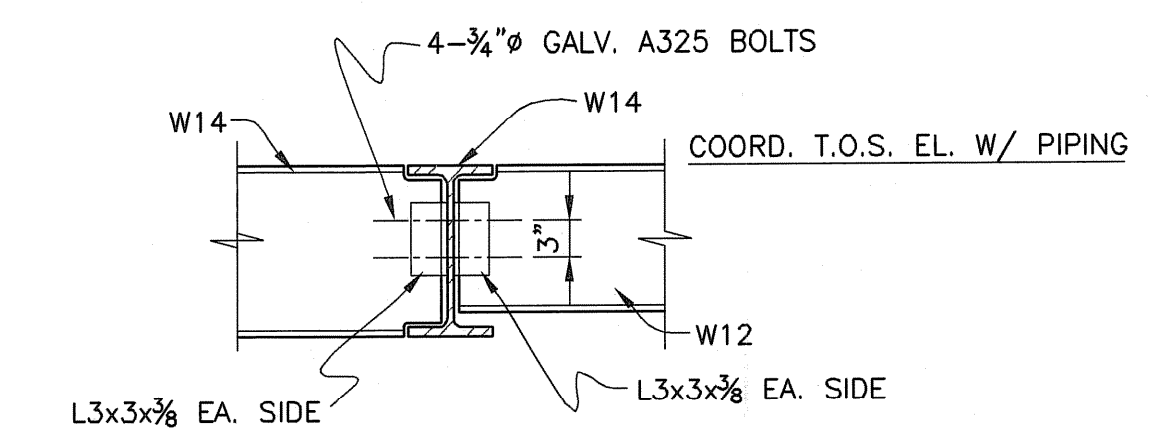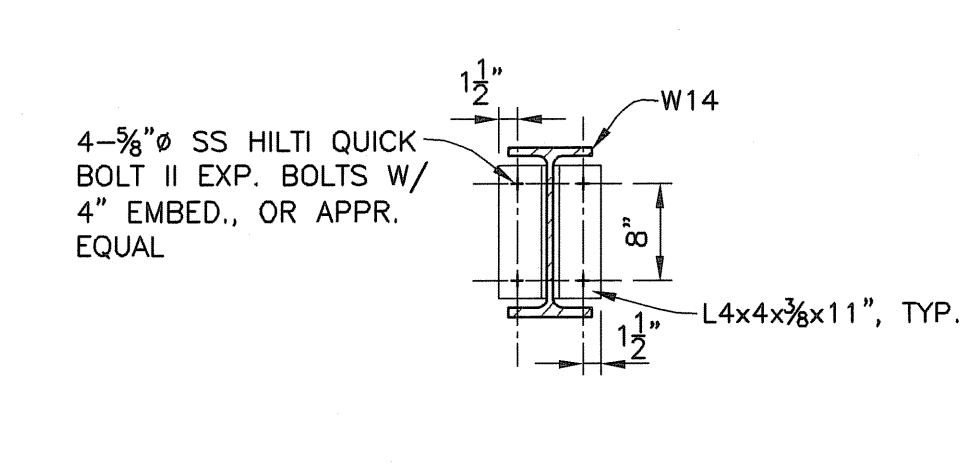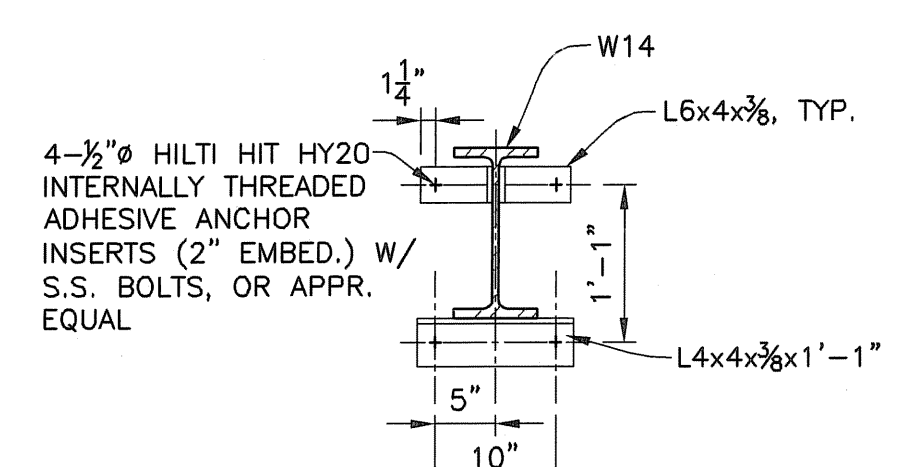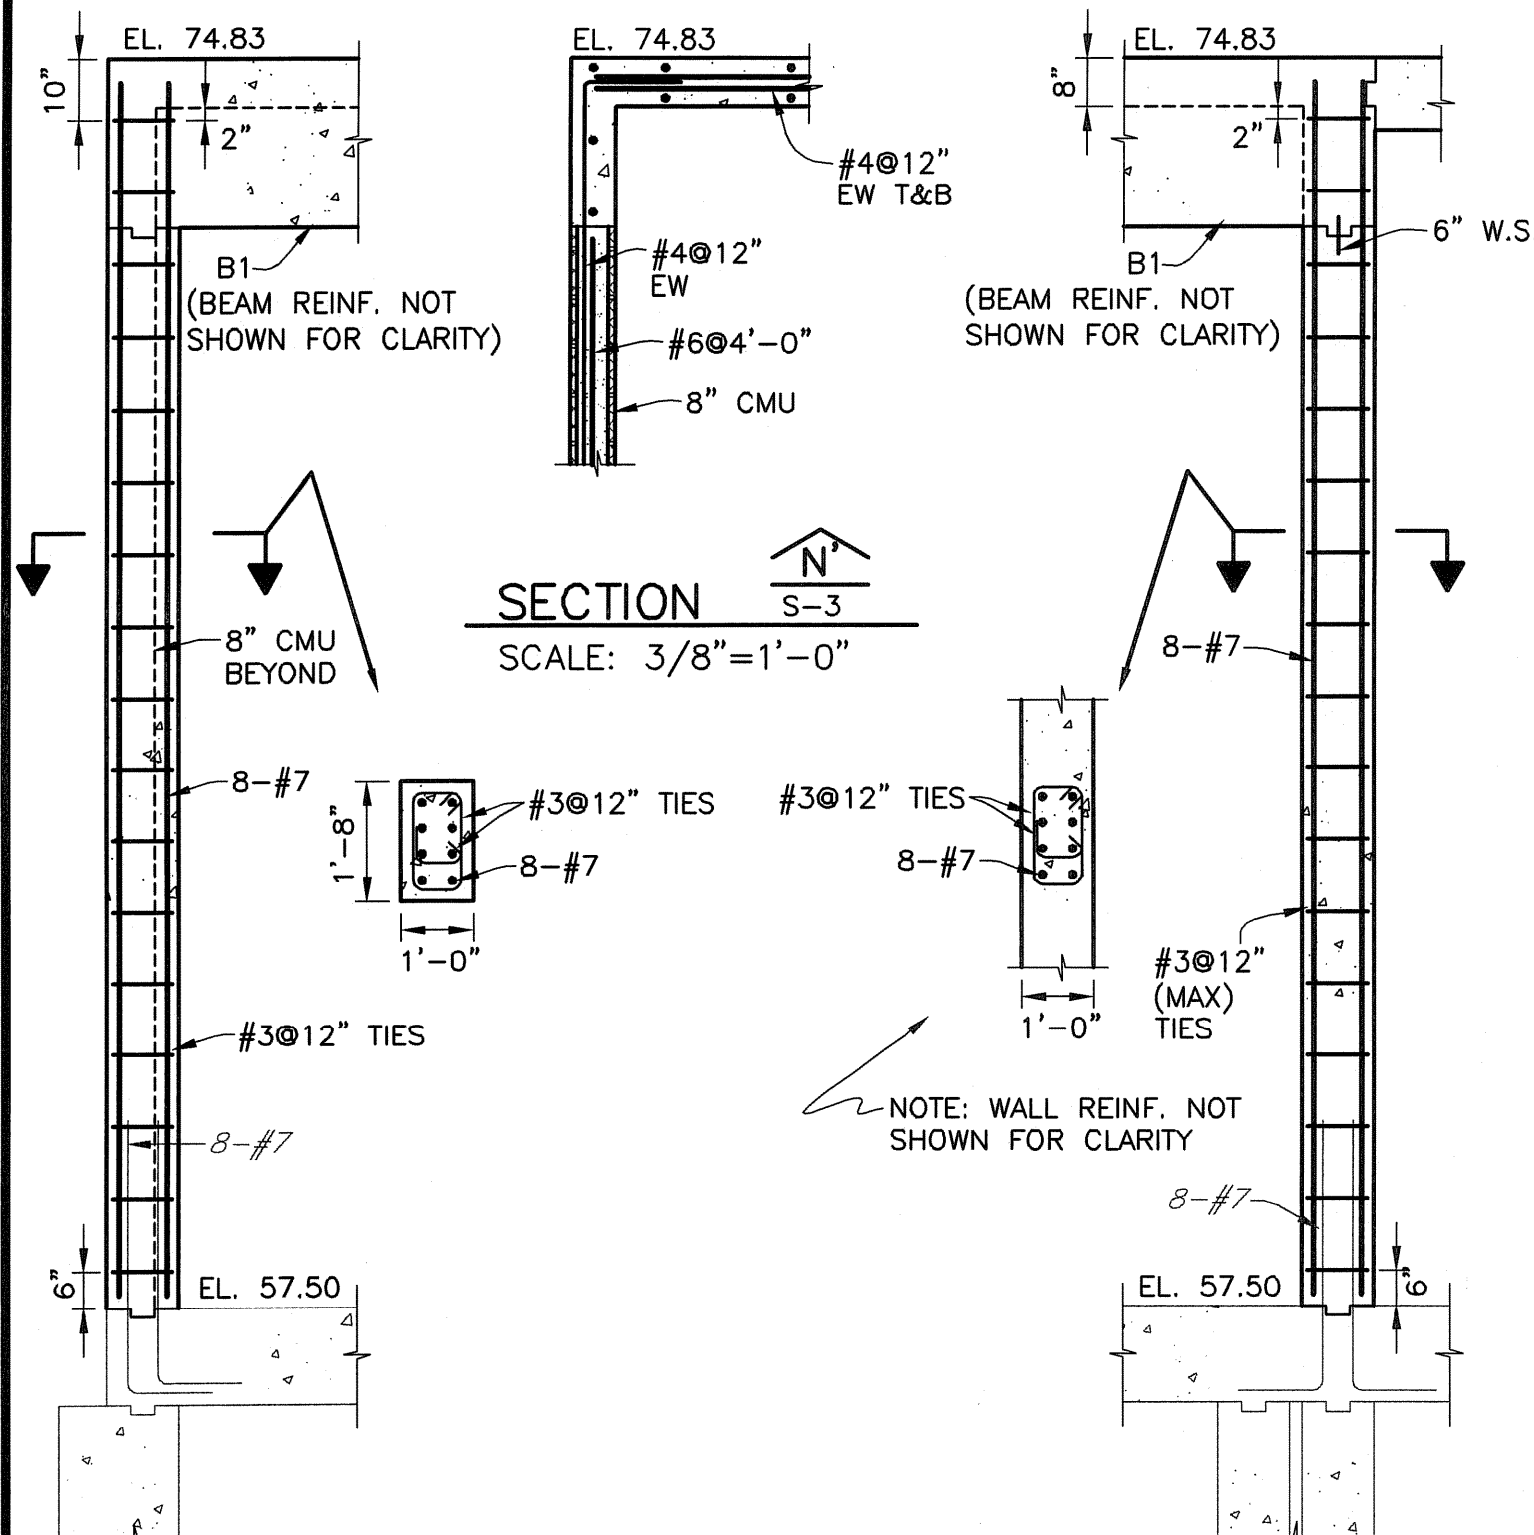


PLAN-GALLERY PIPE SUPPORT FRAMING
 SCALE: 1/8" = 1'-0"

- NOTES:
1. STEEL MEMBERS SHALL BE AS FOLLOWS: W-SHAPES, ASTM A992 (50 KSI); ANGLES, ASTM A36.
 2. ALL STEEL SHALL BE HOT-DIP GALVANIZED.
 3. COORD. EXACT LOCATION OF W14 BEAMS WITH PIPING LAYOUT.
 4. T.O.S. EL. TO BE COORDINATED WITH PIPING.
 5. REFER TO MECHANICAL DRAWINGS AND SPECIFICATIONS FOR PIPE SUPPORT REQUIREMENTS. PROVIDE SUPPORTS AT A MAXIMUM SPACING OF 15'-0" UNLESS A SHORTER MAXIMUM SUPPORT SPACING IS SPECIFIED ELSEWHERE.

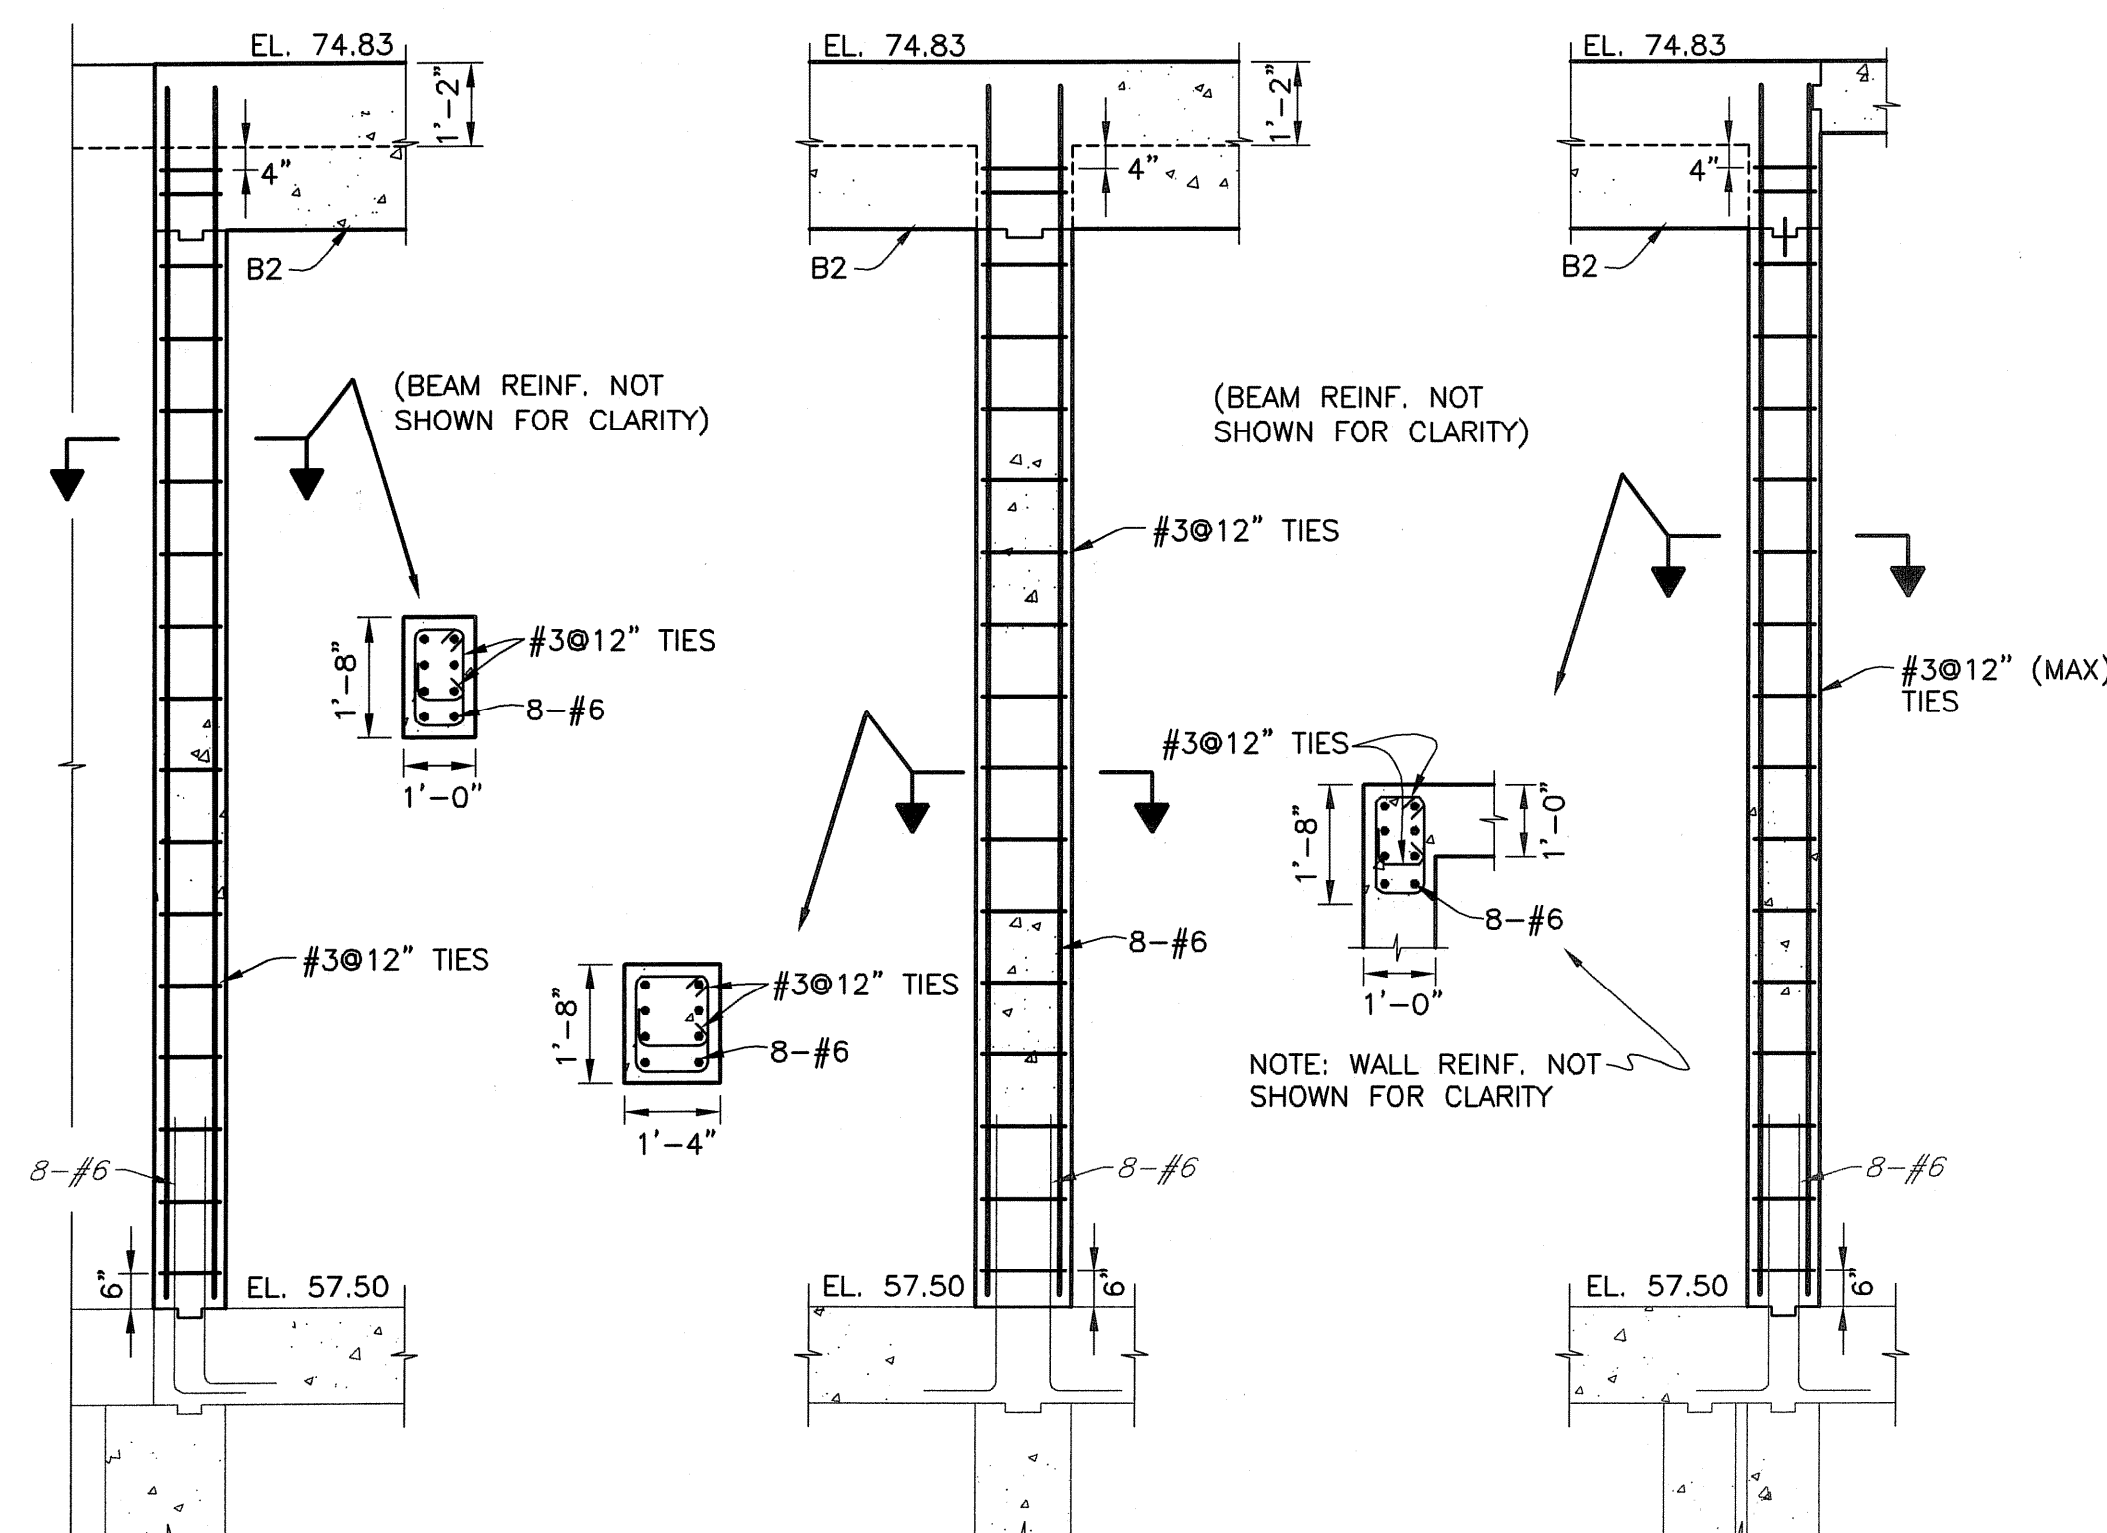

SECTION S-3 (top right) SCALE: 3/8" = 1'-0"
 SECTION S-3 (middle right) SCALE: 3/8" = 1'-0"
 SECTION S-3 (bottom right) SCALE: 3/8" = 1'-0"

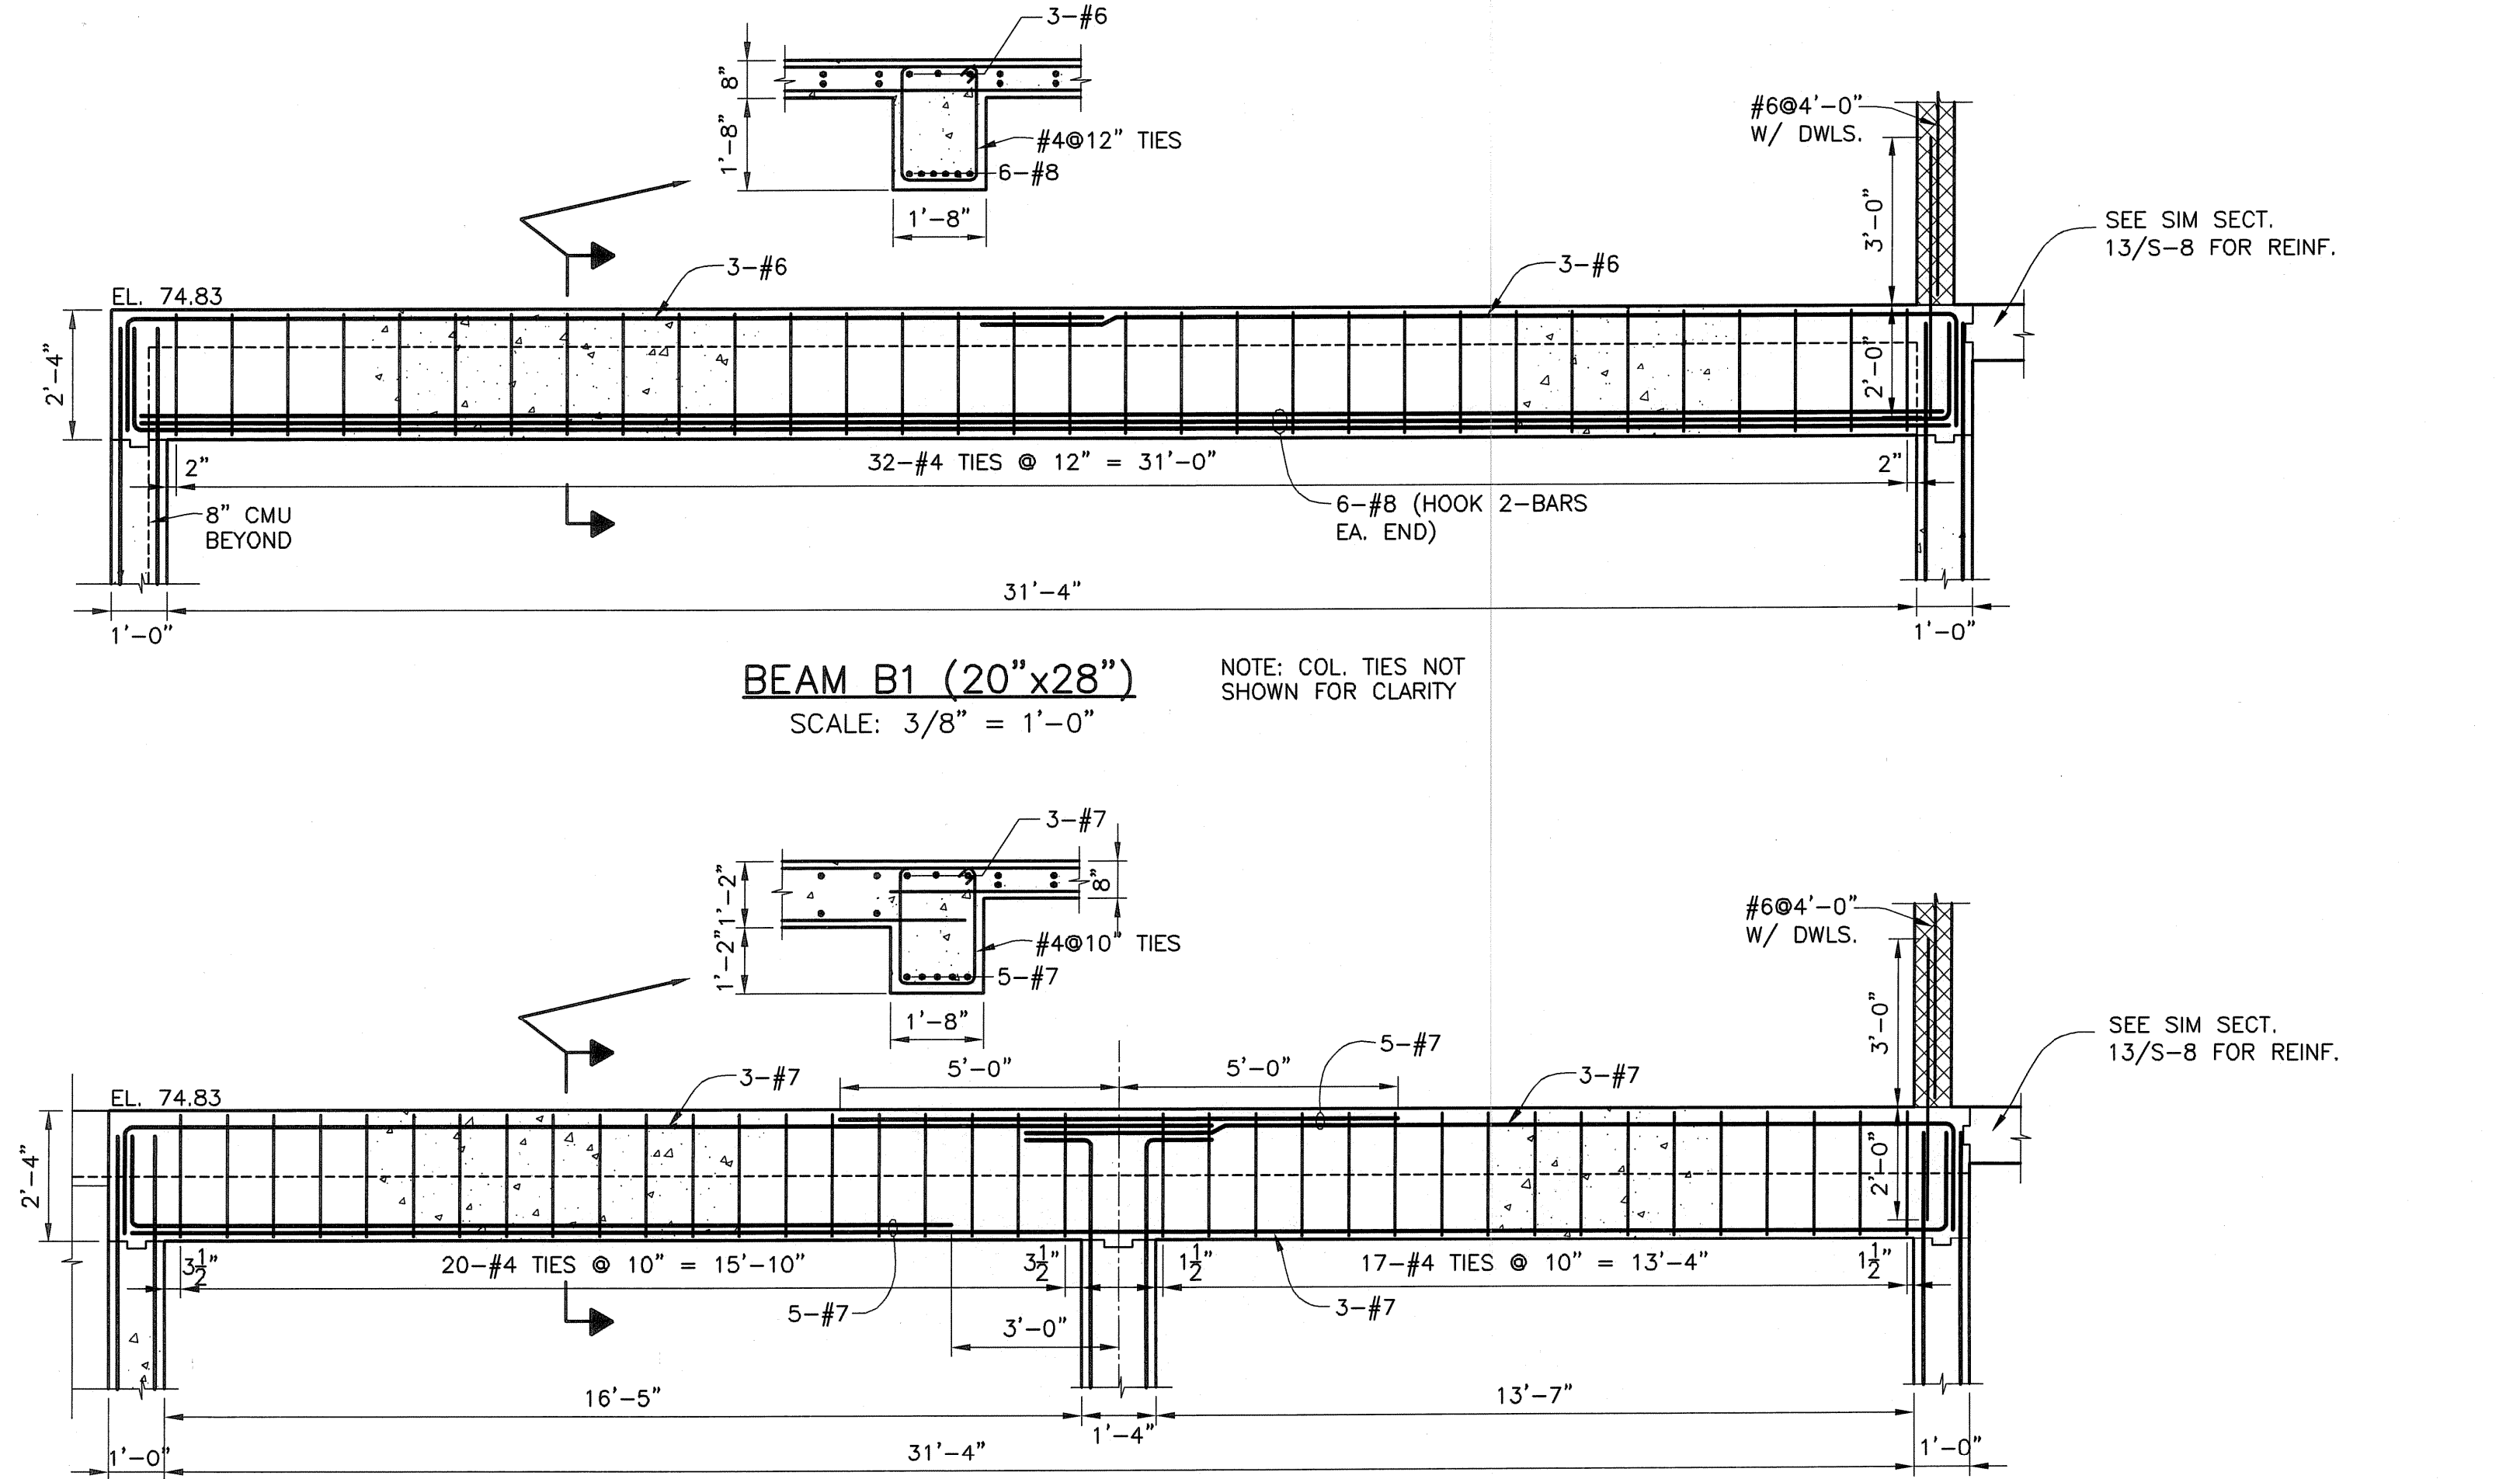


BEAM B1 (20"x28") SCALE: 3/8" = 1'-0"
 BEAM B2 (20"x28") SCALE: 3/8" = 1'-0"

EARTH TECH
 AS-BUILT FILE
 JULY 2008

EarthTech
 A Tyco International Ltd. Company
 300 BAKER AVENUE SUITE 200 CONCORD MA 01742 (978) 371-4000


<p>ROBERT H. SHELDON 4103 PROFESSIONAL ENGINEER STATE OF MASSACHUSETTS LICENSE NO. 10173</p>	<p>PAWTUCKET, RHODE ISLAND PAWTUCKET REGIONAL WATER TREATMENT FACILITY PKG 9 - UPPER CONCRETE PIPE GALLERY-PIPE SUPPORT FRAMING PLAN, AND SECTIONS AND DETAILS</p>												
<table border="1" style="width: 100%; border-collapse: collapse;"> <tr> <td>DESIGNED BY</td> <td>MWC</td> <td>DWG SCALE</td> <td>AS NOTED</td> </tr> <tr> <td>DRAWN BY</td> <td>MWC</td> <td>CONTRACT NO.</td> <td></td> </tr> <tr> <td>CHECKED BY</td> <td>R.D.</td> <td>DATE</td> <td>OCTOBER 31, 2008</td> </tr> </table>	DESIGNED BY	MWC	DWG SCALE	AS NOTED	DRAWN BY	MWC	CONTRACT NO.		CHECKED BY	R.D.	DATE	OCTOBER 31, 2008	<p>S-11 SHEET OF</p>
DESIGNED BY	MWC	DWG SCALE	AS NOTED										
DRAWN BY	MWC	CONTRACT NO.											
CHECKED BY	R.D.	DATE	OCTOBER 31, 2008										

Filename: L:\WORK\68993\CAD\AS-BUILT\9) WTP\STRUC\68993S3-5-11-12.DWG
 Plot Date: Aug/11/2008 4:03 PM

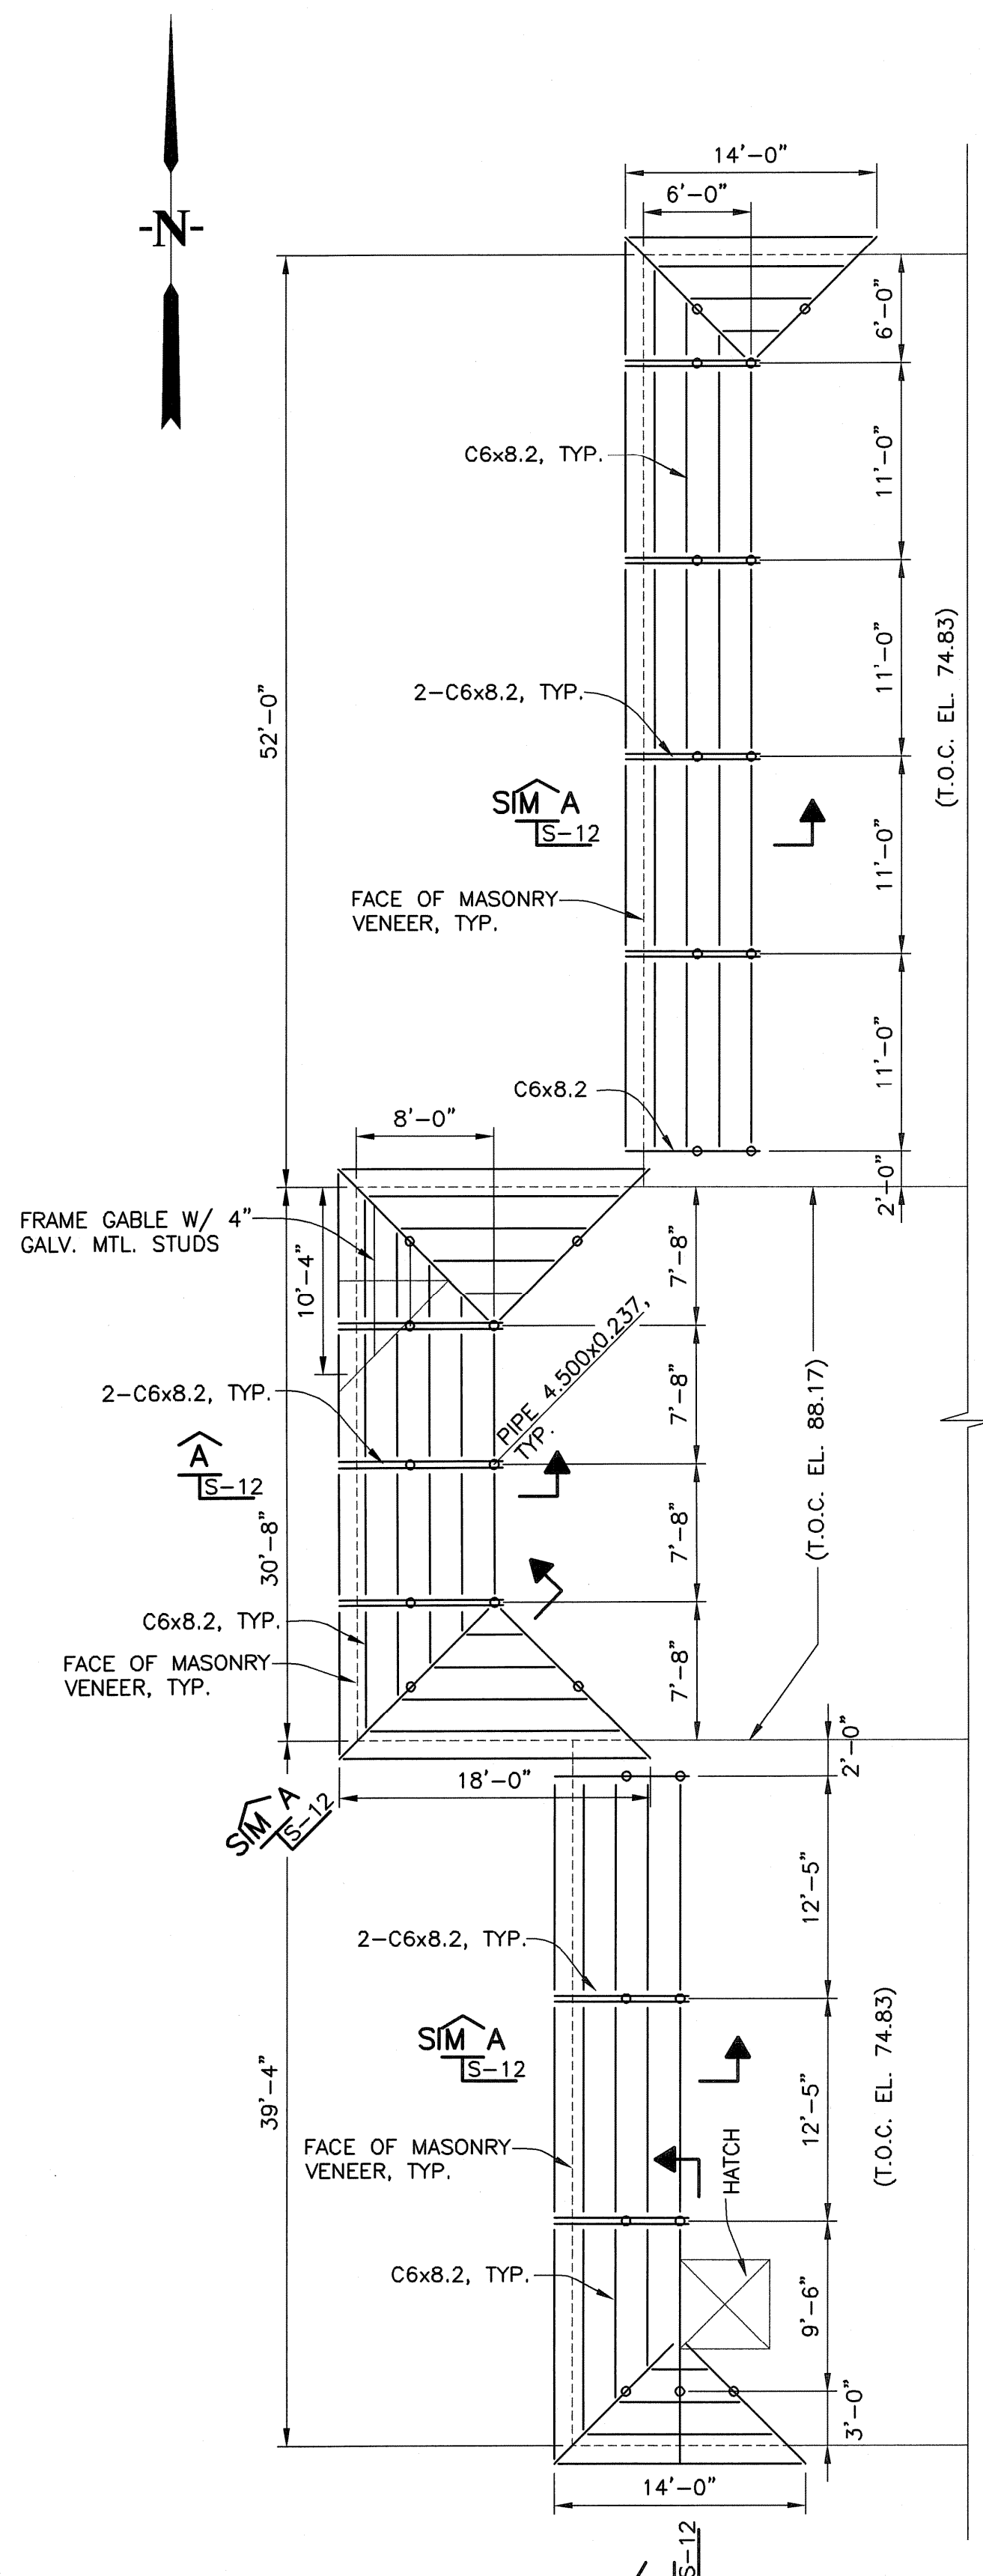


- NOTES:**
1. ALL FRAMING TO BE HOT DIP GALVANIZED.
 2. CHANNELS SHALL BE ASTM A36 STEEL, PIPE SHALL BE ASTM A53, GRADE B STEEL.
 3. FASCIA SEGMENTS (EXCEPT POSTS) ARE TO BE INDEPENDENTLY REMOVABLE IN FRAMED SEGMENTS AS SHOWN (W/ JOINTS LOCATED BETWEEN 2C-6, TYP.).

PLAN-ROOF FASCIA FRAMING
 SCALE: 1/8" = 1'-0"

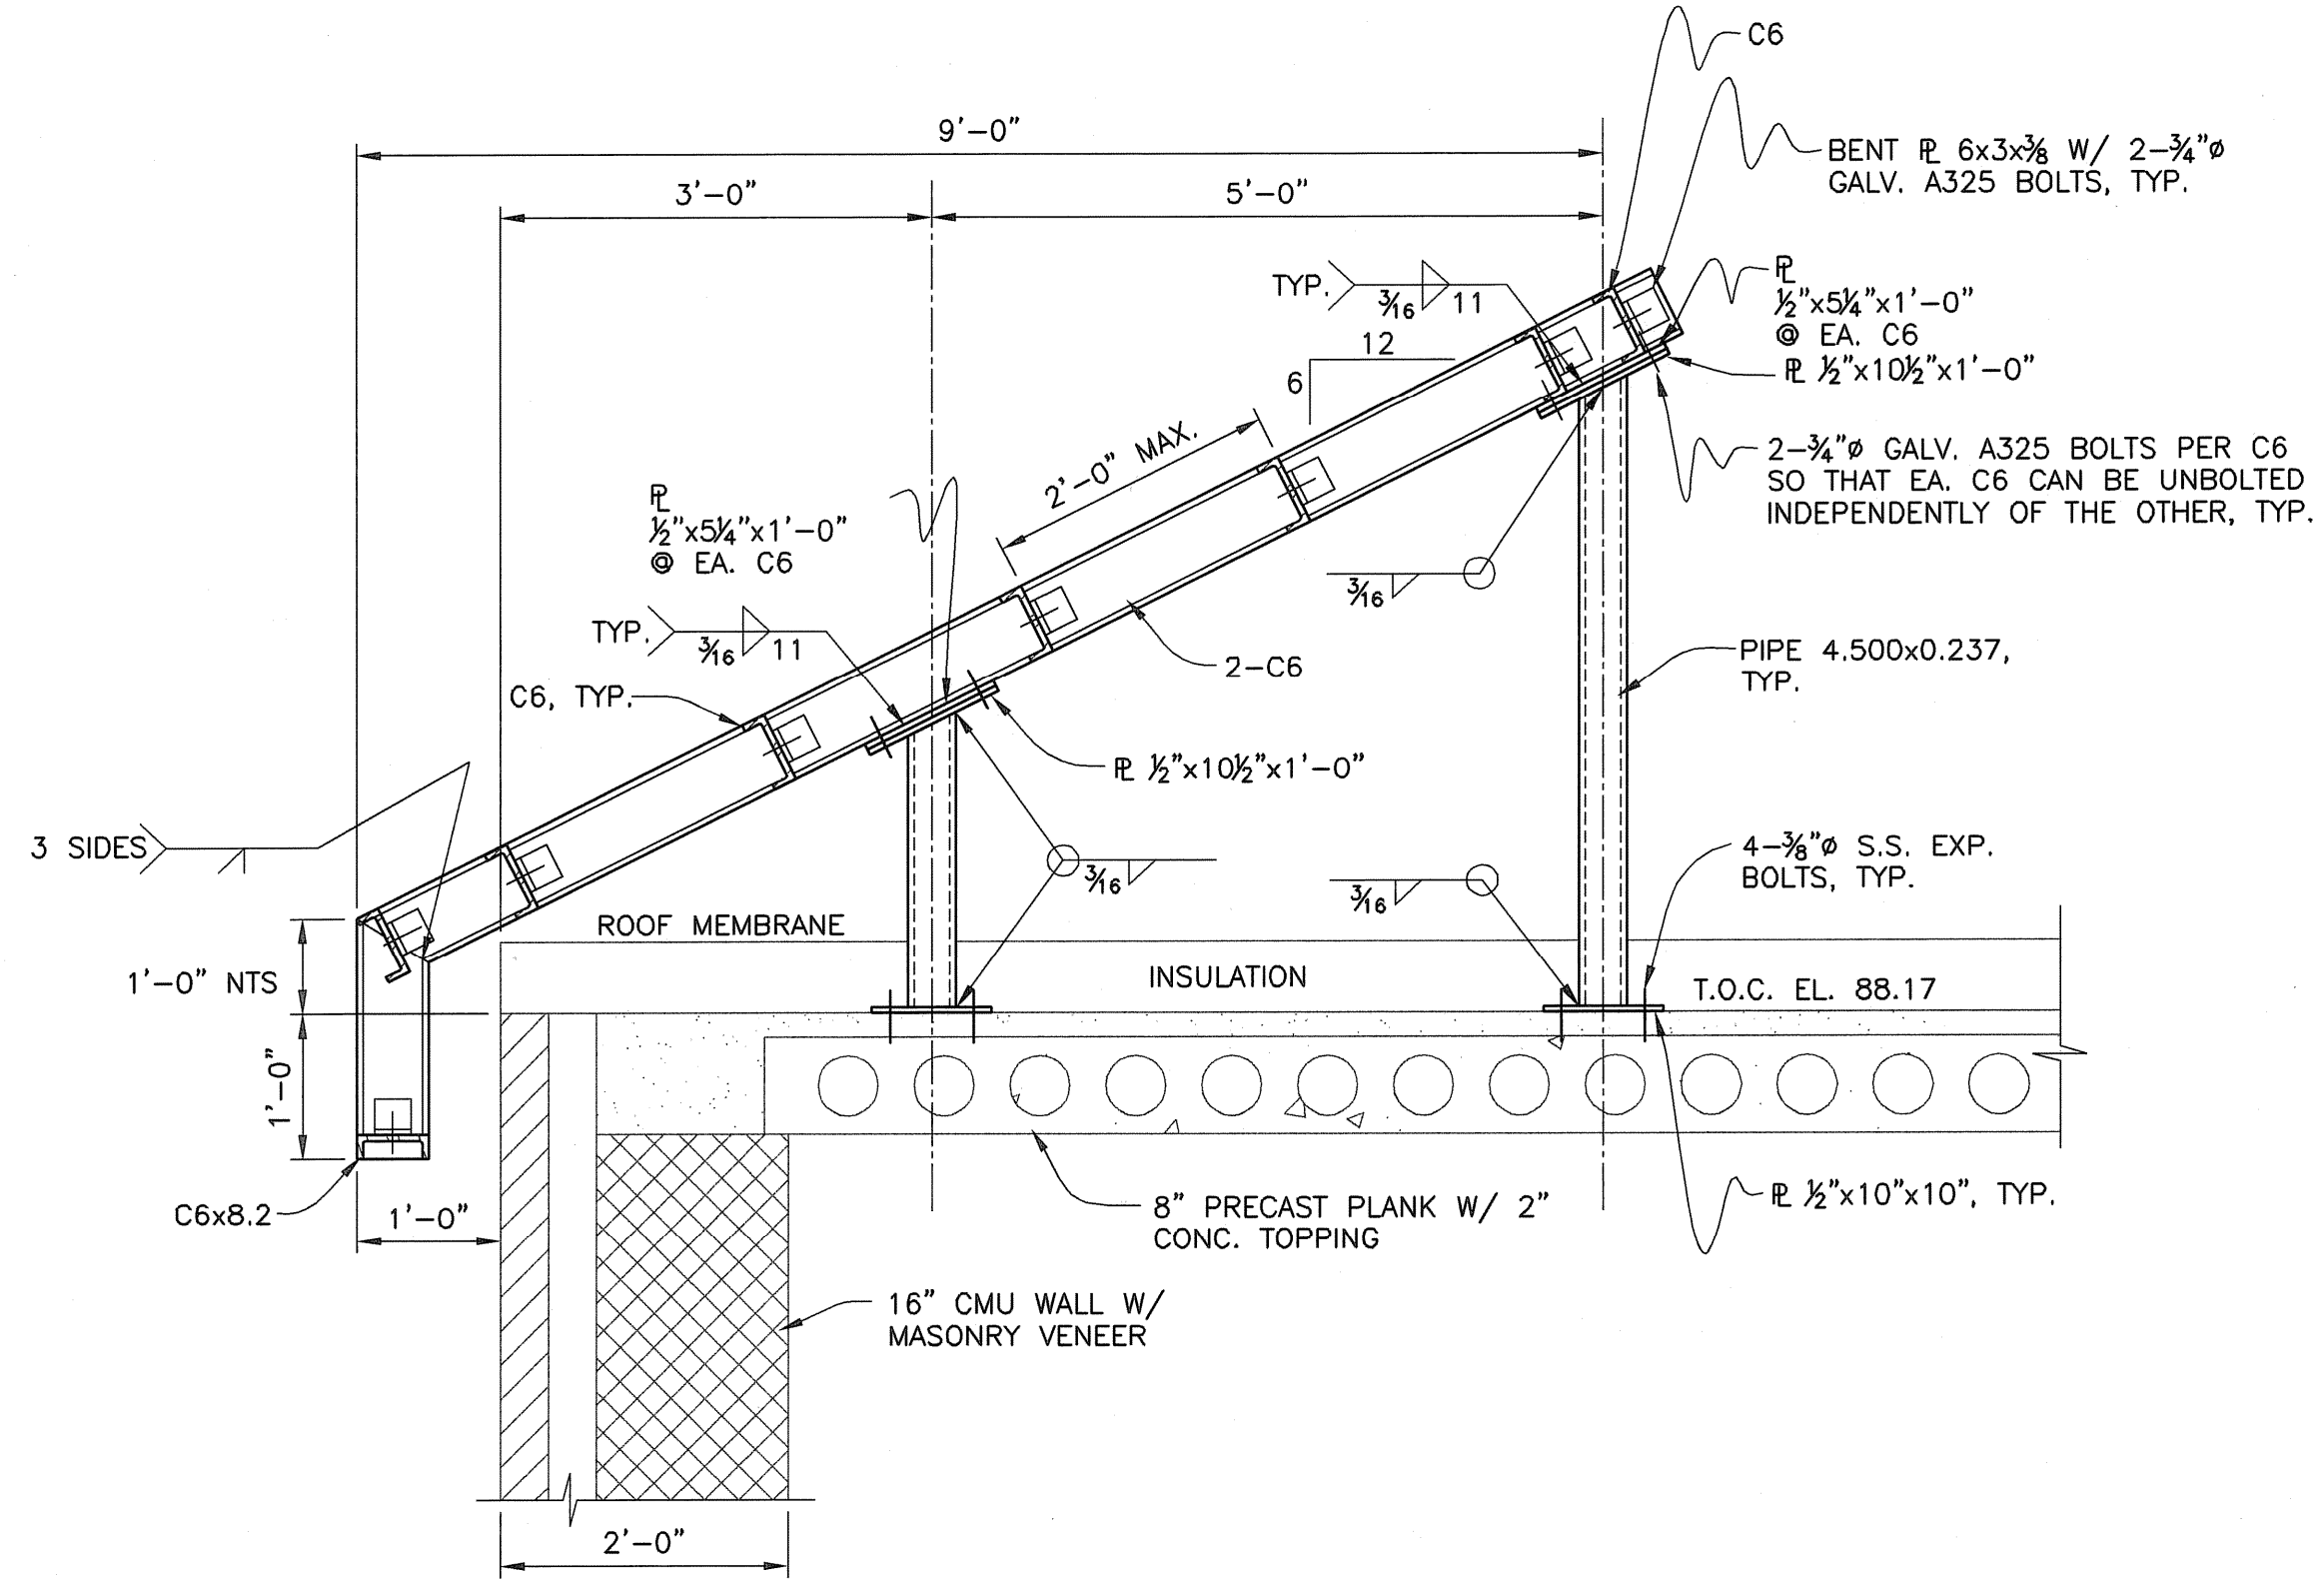


SECTION A-S-12
 SCALE: 3/4" = 1'-0"

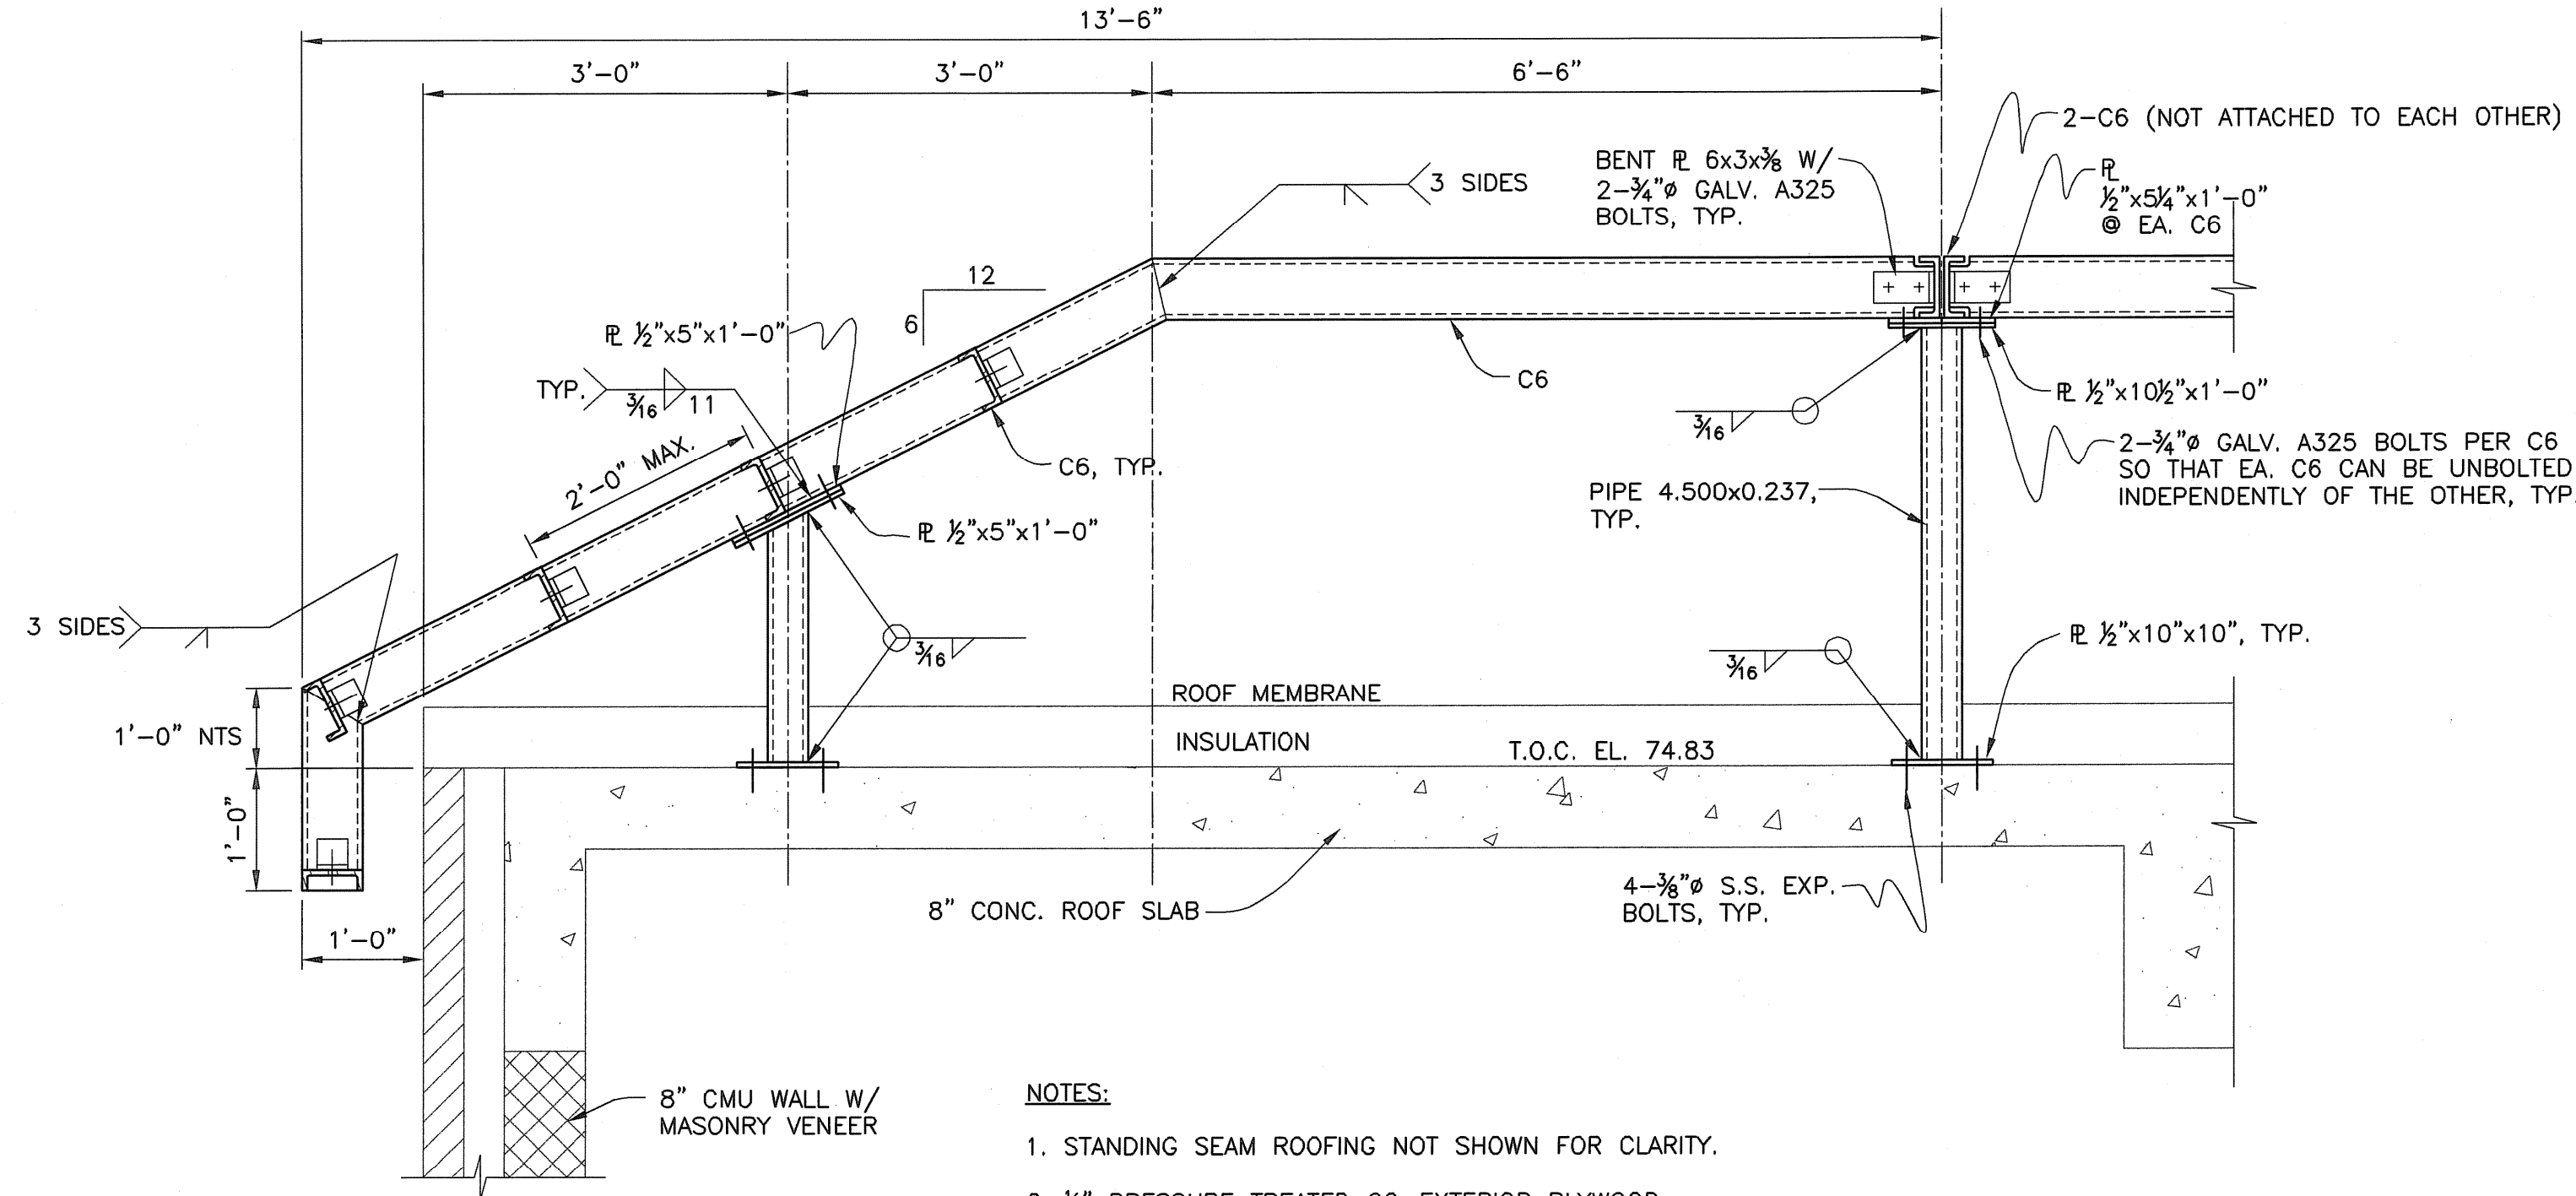


- NOTES:**
1. STANDING SEAM ROOFING NOT SHOWN FOR CLARITY.
 2. 1/2" PRESSURE TREATED CC-EXTERIOR PLYWOOD SHEATHING NOT SHOWN FOR CLARITY. PROVIDE CONTINUOUS JOINT THROUGH SHEATHING BETWEEN 2-C6x8.2, TYP.
 3. ATTACH PLYWOOD SHEATHING TO FRAMING WITH GALV. SELF-TAPPING SCREWS 1'-0" O.C. AT ALL SUPPORTS.
 4. ROOF SLAB REINFORCING AND ROOF HATCH NOT SHOWN.

SECTION B-S-12
 SCALE: 3/4" = 1'-0"

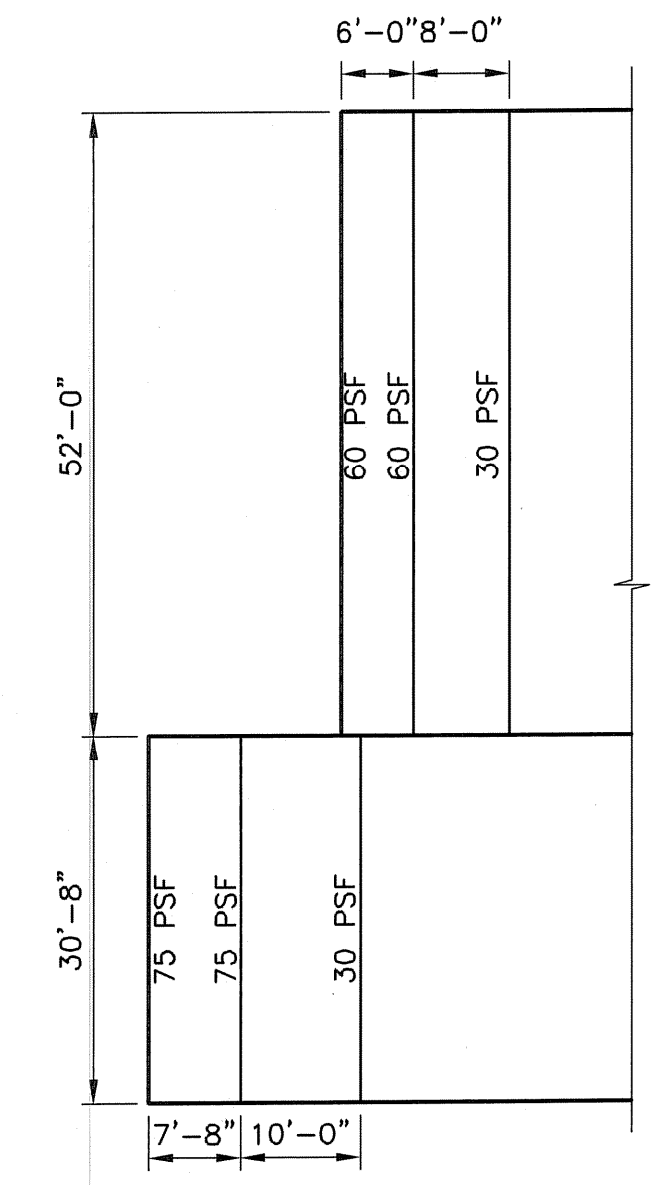


ROOF SNOW LOAD - NORTHWEST END
 SCALE: 1/16" = 1'-0"



EarthTech
 A Tyco International Ltd. Company
 300 BAKER AVENUE SUITE 200 CONCORD MA 01742 (978) 371-4000

FULL SIZE DRAWING = 4"	
AS-BUILT DRAWING FILE	DATE
2	08 JULY 2008
1	ISSUED FOR RFI POSTED SET R.D. 10/31/06
0	ISSUED FOR CONSTRUCTION R.D. 4/05
NO.	BY

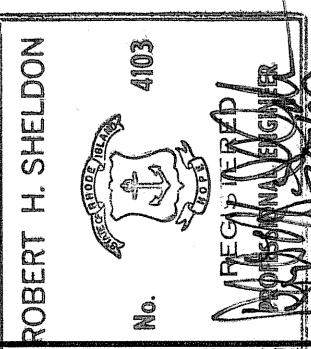

ROBERT H. SHELDON
 No. 4103
 REGISTERED PROFESSIONAL ENGINEER
 STATE OF MASSACHUSETTS


PAWTUCKET, RHODE ISLAND
PAWTUCKET REGIONAL WATER TREATMENT FACILITY
PKG 9 - UPPER CONCRETE ROOF FASCIA FRAMING PLAN & SECTIONS AND DETAILS

DESIGNED BY MWC	DWG SCALE AS NOTED
DRAWN BY MWC	CONTRACT NO.
CHECKED BY R.D.	DATE OCTOBER 31, 2006


EARTH TECH
AS-BUILT FILE
JULY 2008

S-12
 SHEET OF

Filename: L:\WORK\69993\CAD\AS-BUILT\9) WTP\STRUC\69993S-13.DWG
 Plot File Date Created: Aug/11/2008 4:09 PM

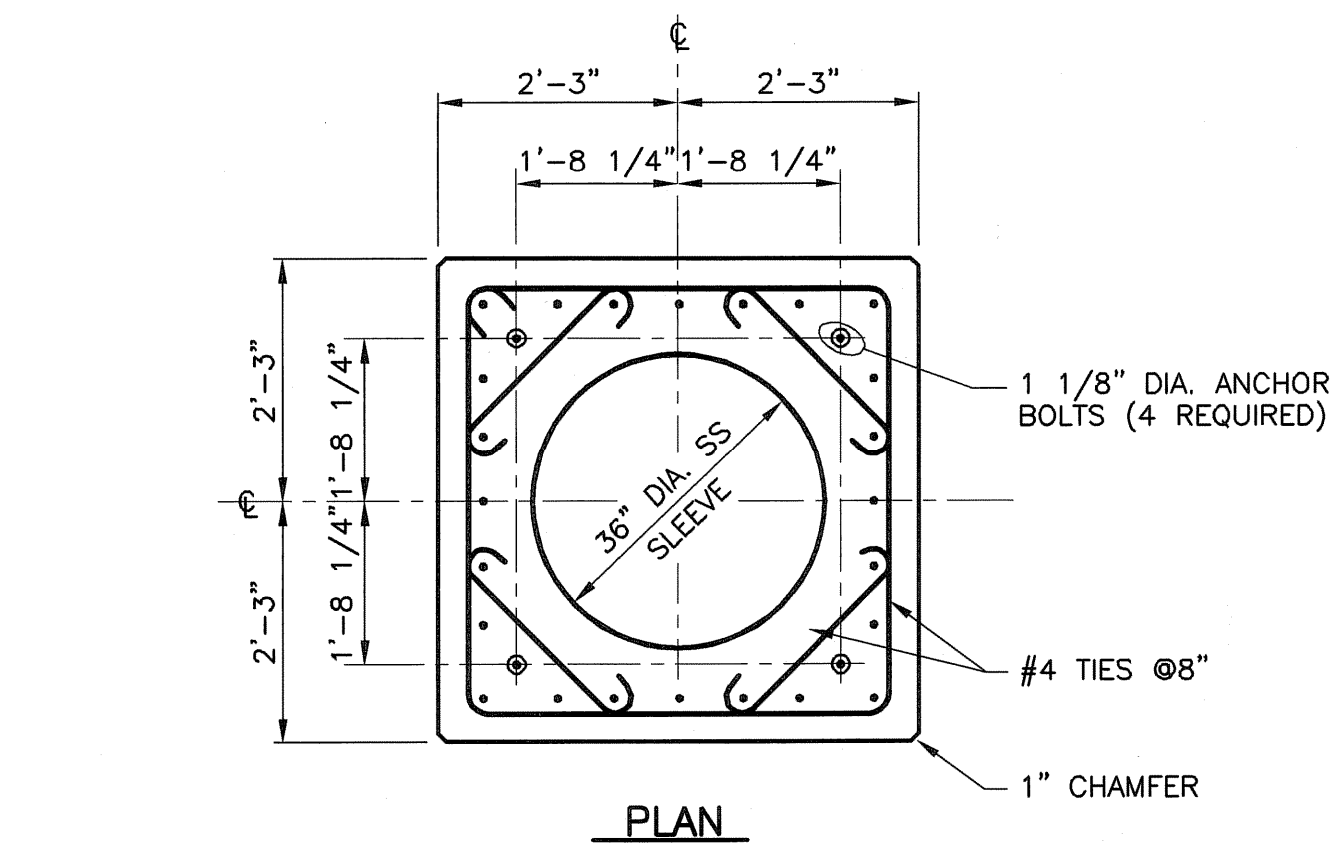


PLAN

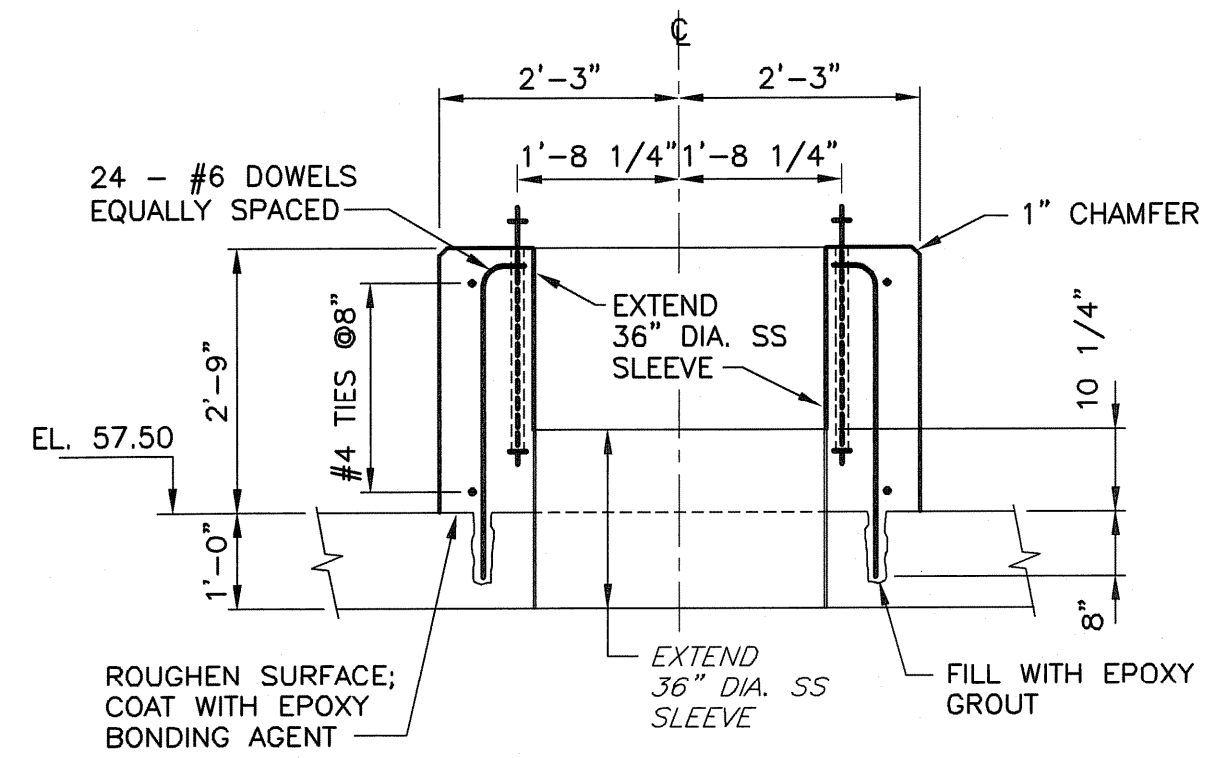


SECTION

HS PUMPS
 NOT TO SCALE
 (REQUIRED 4 PLACES)

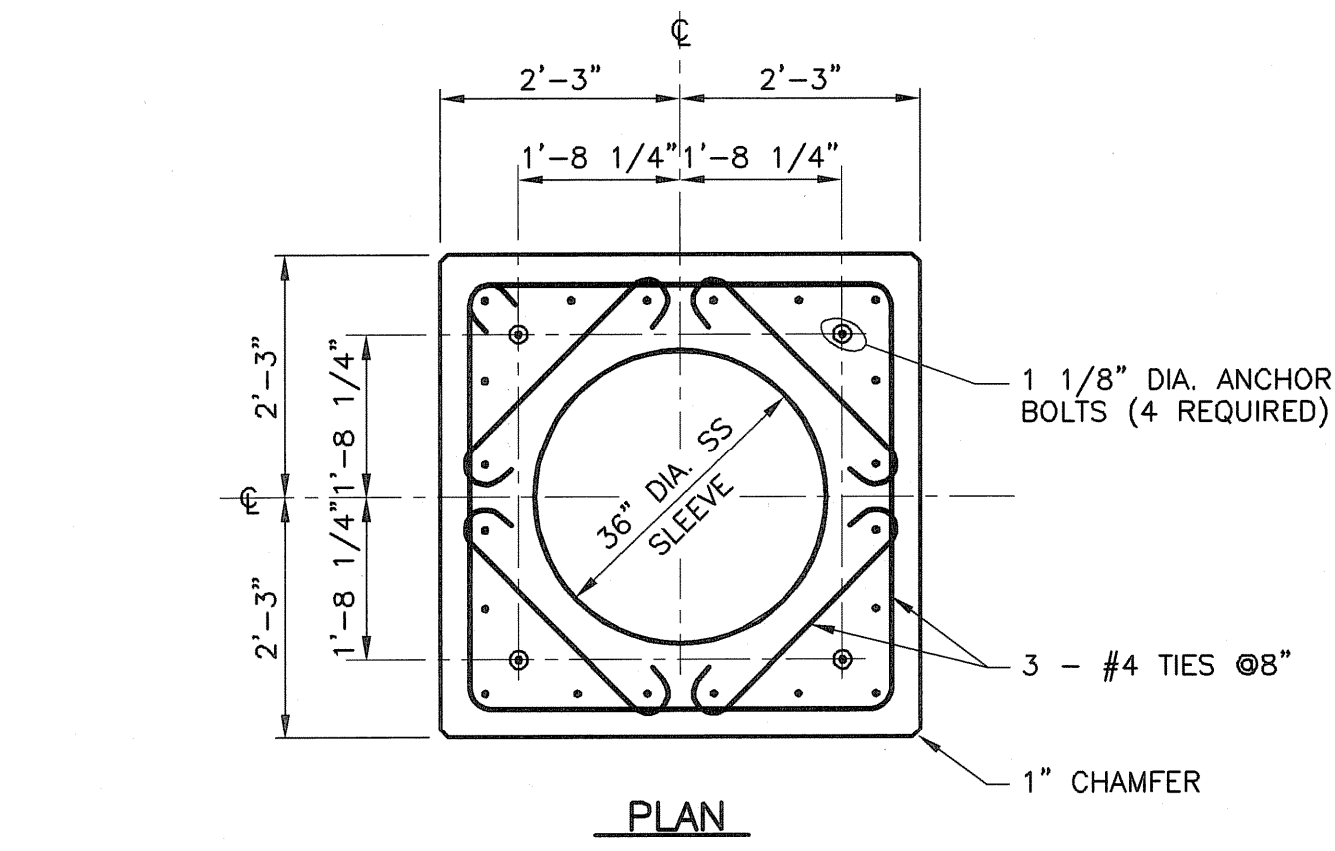


PLAN

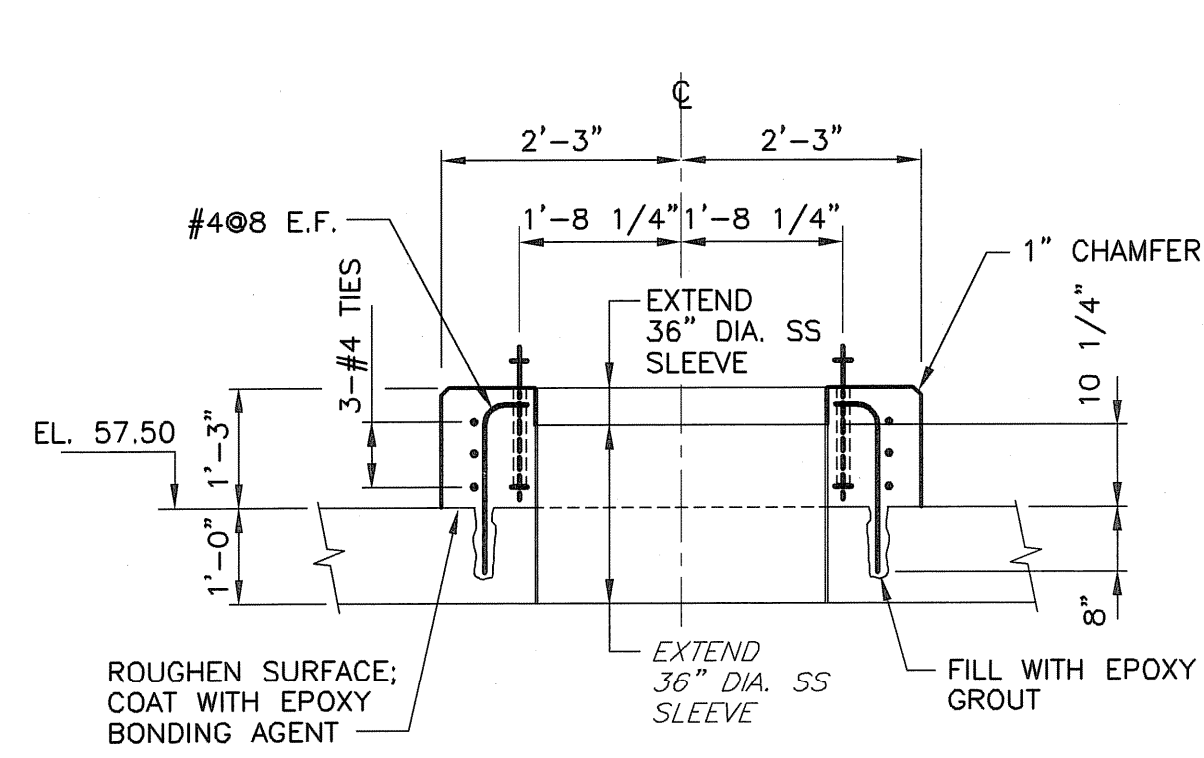


SECTION

FBW PUMPS
 NOT TO SCALE
 (REQUIRED 2 PLACES)

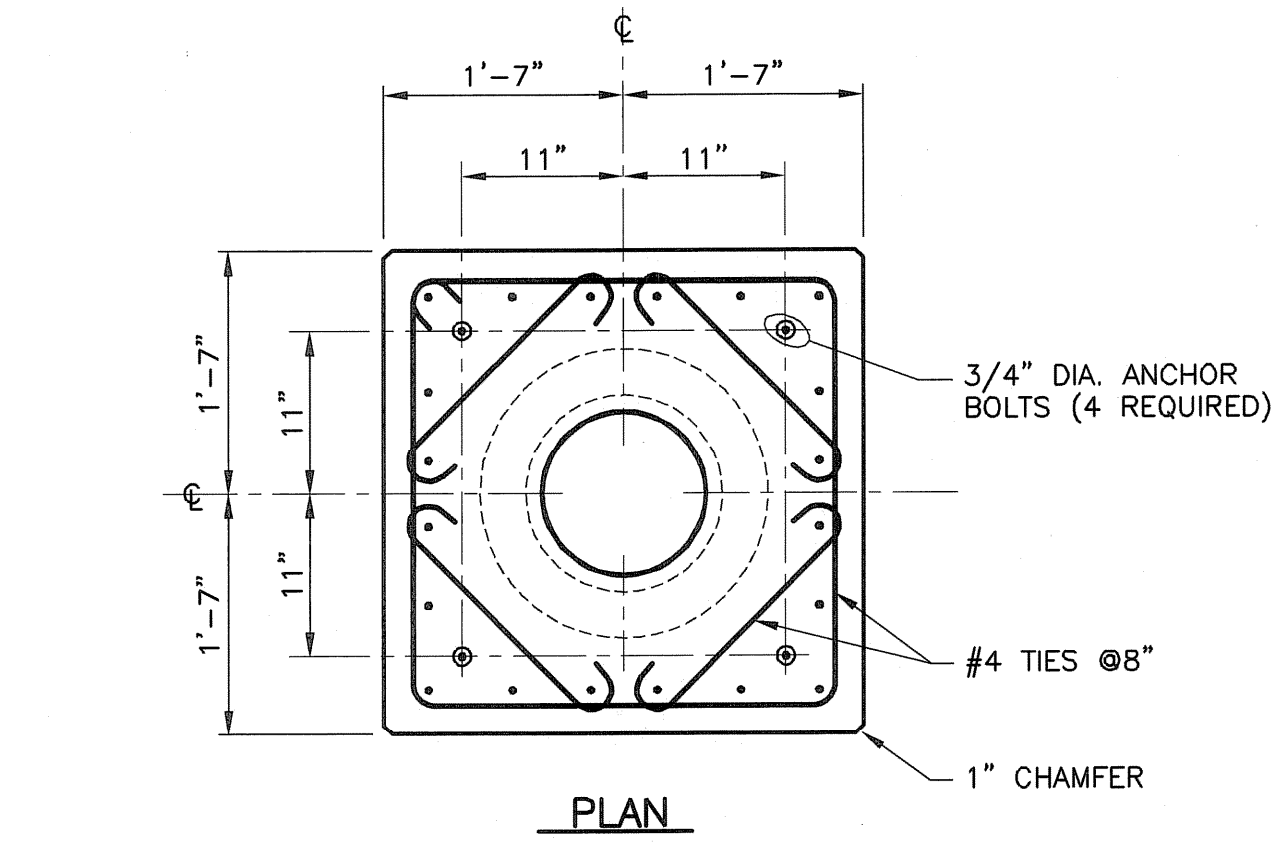


PLAN

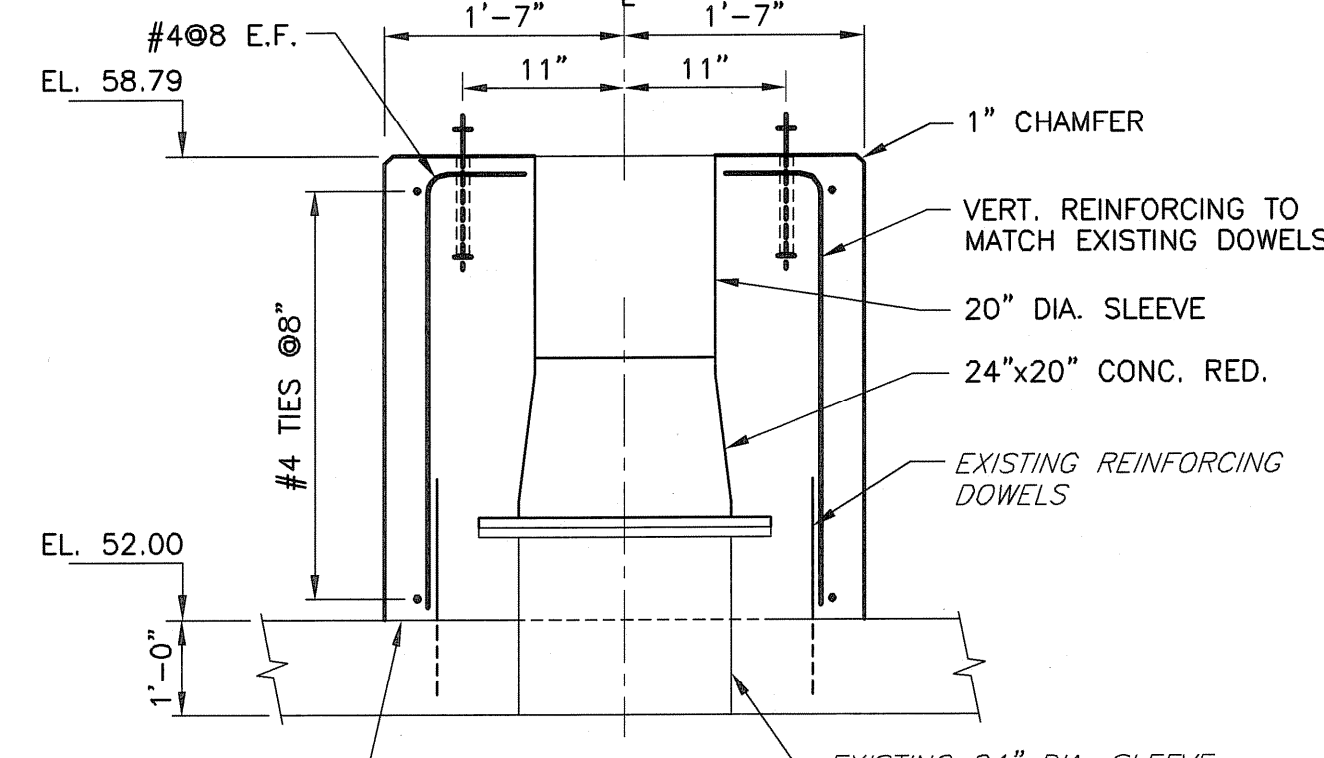

SECTION


EB PUMPS
 NOT TO SCALE
 (REQUIRED 4 PLACES)

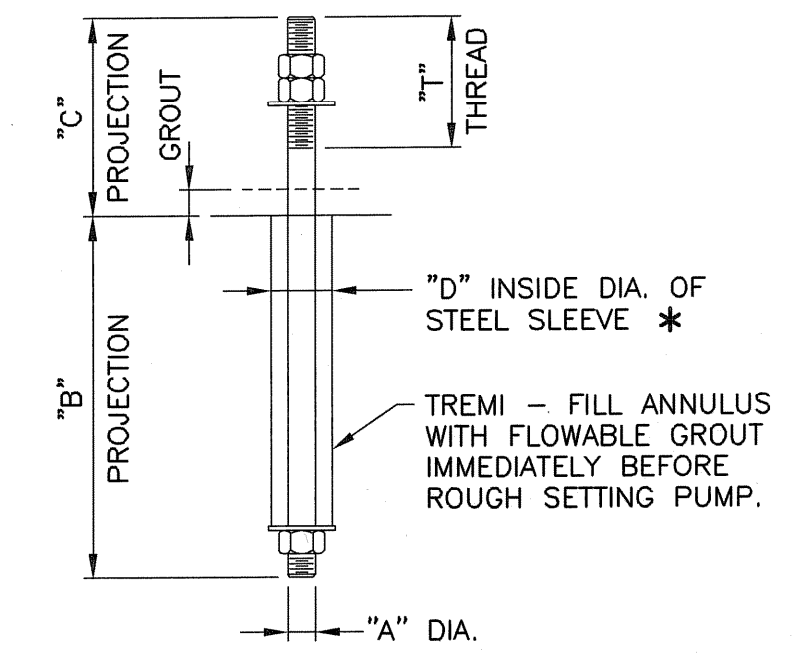

ANCHOR BOLT SCHEDULE

	"A"	"B"	"C"	"D"	"T"
HS PUMPS	1 1/8"	24"	8"	3"	5"
FBW PUMPS	1 1/8"	12"	6 3/4"	3"	4"
EB PUMPS	3/4"	24"	8"	3"	5"


* - ANCHOR SLEEVE CAN BE REPLACED WITH WILSON ANCHOR SLEEVE, APPROPRIATLY SIZED.

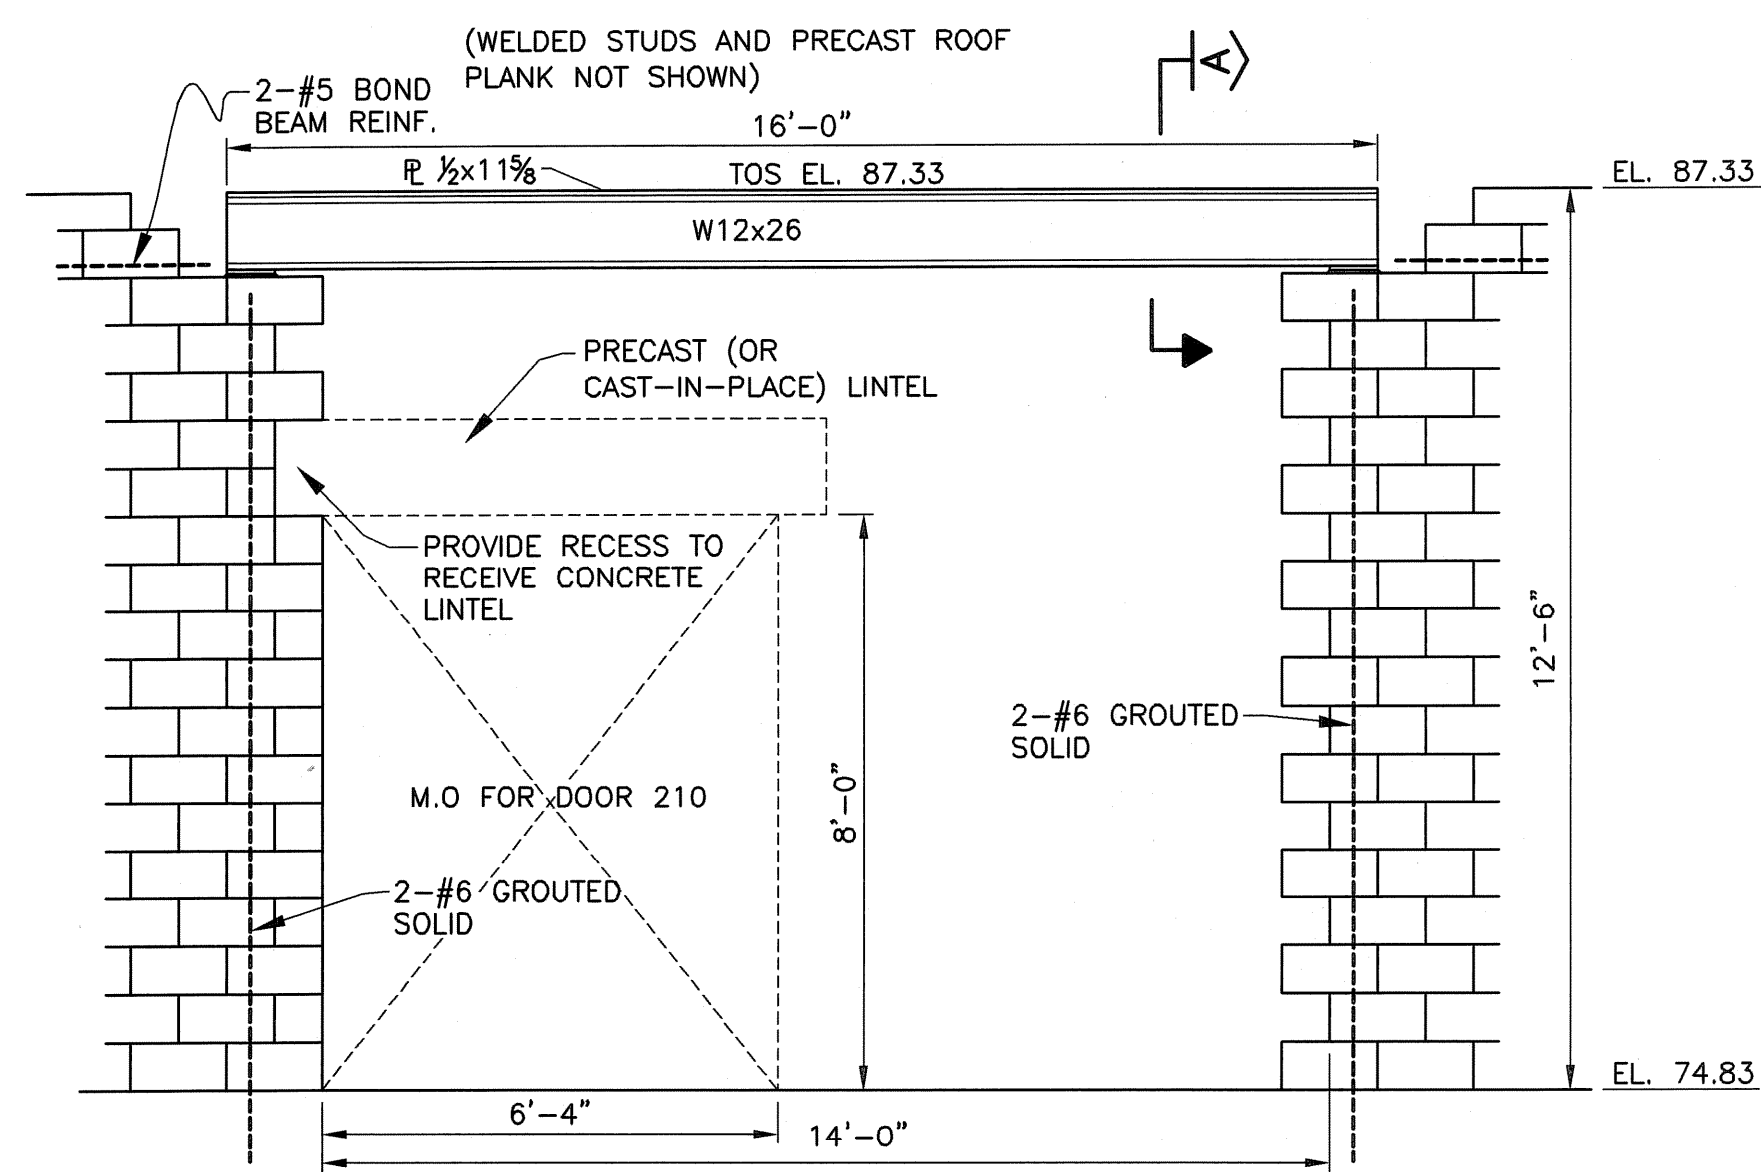

NOTES:

- MASONRY CLOSURE TO BE REINFORCED W/ 2-#6 @ 4'-0" O.C., AS SPECIFIED.
- W12 SHALL BE ENCASED IN CONCRETE AFTER CMU INFILL WALL IS CONSTRUCTED.

RFI 00295-TEMPORARY OP'NG AT DOOR 210 (ELEC. RM)
 SCALE: 3/8" = 1'-0"

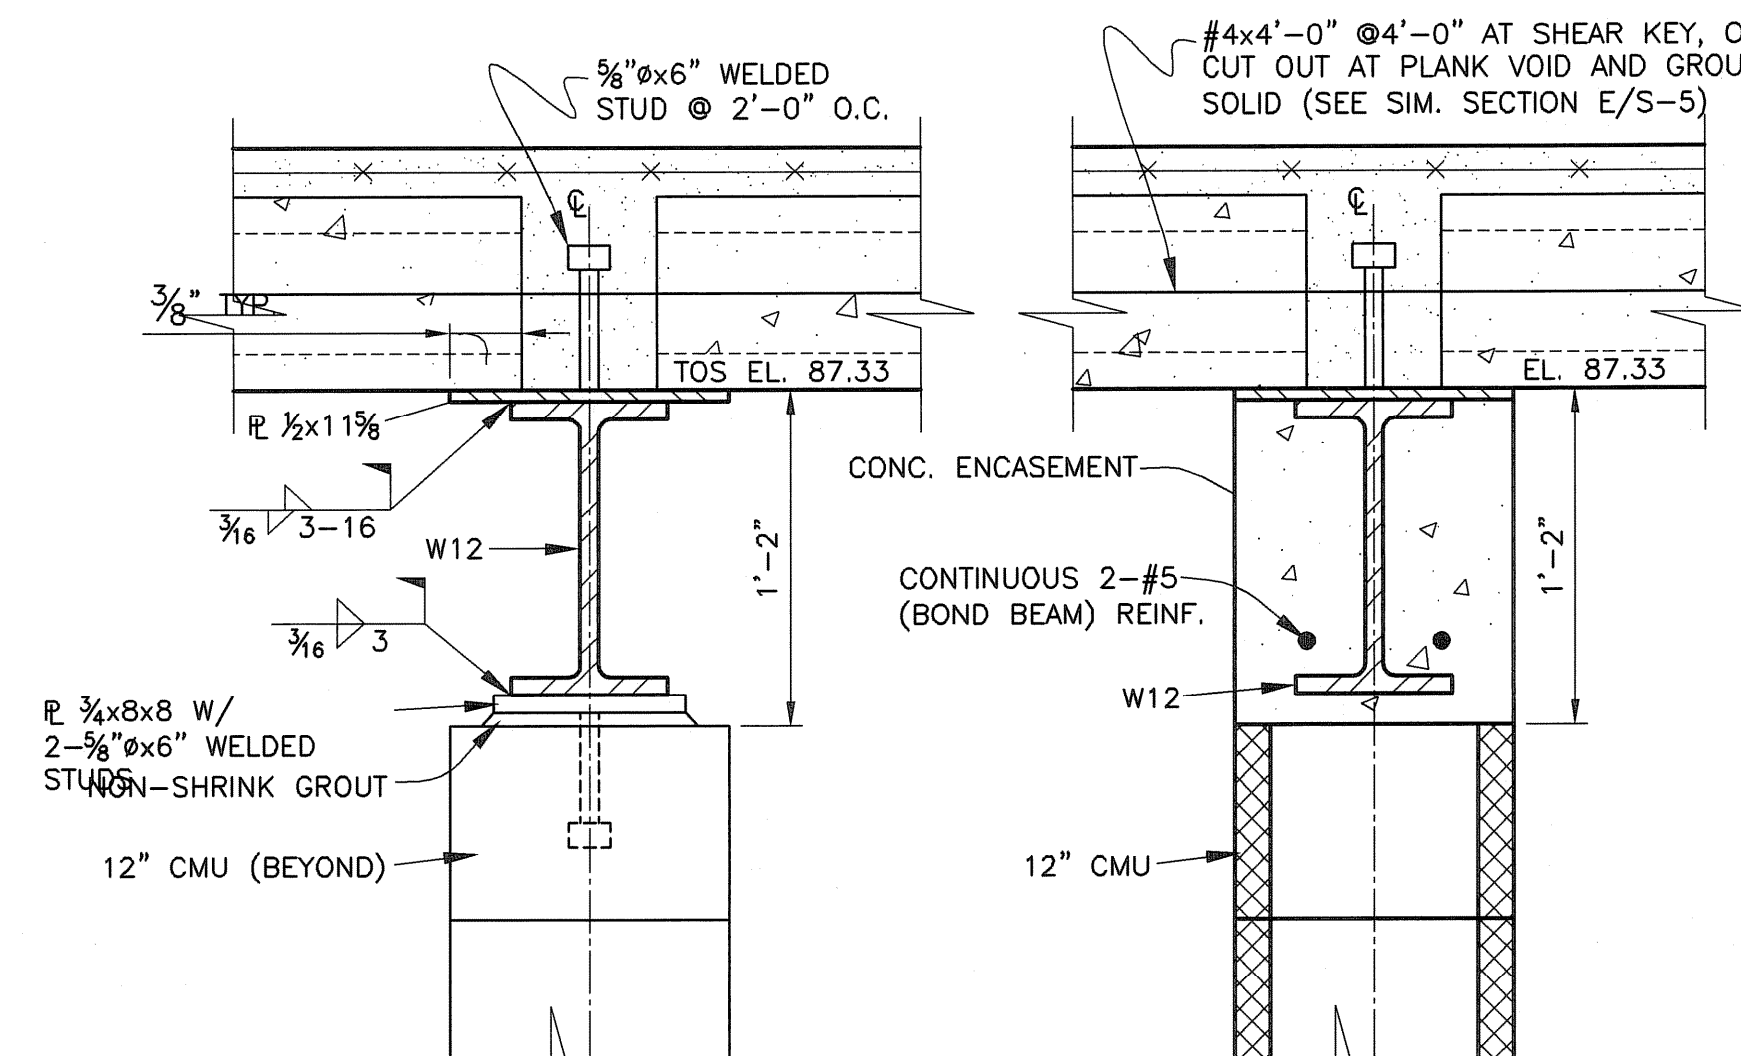

NOTES:

- AS SHOWN FOR TEMPORARY OP'NG.
- BEARING TYPICAL, EA. END.

SECTION A
 SCALE: 1 1/2" = 1'-0"

NOTES:

- AS SHOWN FOR FINAL CLOSURE.

SECTION A
 SCALE: 1 1/2" = 1'-0"

FULL SIZE DRAWING = 4"

NO.	BY	DATE	REVISIONS
2	DPB	JULY 2008	AS-BUILT DRAWING FILE
1	R.D.	10/31/06	ISSUED FOR RFI POSTED SET
0	R.D.	4/05	ISSUED FOR CONSTRUCTION

ROBERT H. SHELDON
 No. 4103
 REGISTERED PROFESSIONAL ENGINEER

PAWTUCKET, RHODE ISLAND
**PAWTUCKET REGIONAL
 WATER TREATMENT FACILITY**
PKG 9 - UPPER CONCRETE
 PUMP BASE DETAILS

DESIGNED BY	DPB	DWG SCALE	3/8" = 1'-0"
DRAWN BY	DPB	CONTRACT NO.	
CHECKED BY		DATE	OCTOBER 31, 2008

EARTH TECH
 AS-BUILT FILE
 JULY 2008